

Sec. 16 Twp. 19 R. 10-W ✓

Well No. #2 Bernstorf Farm

S. E. Likins etal Company

Stagg Drlg. Contractor


Silica
990 Ft. from N. Line

 Ft. from S. Line

330 Ft. from E. Line

 Ft. from W. Line

SE NE SE

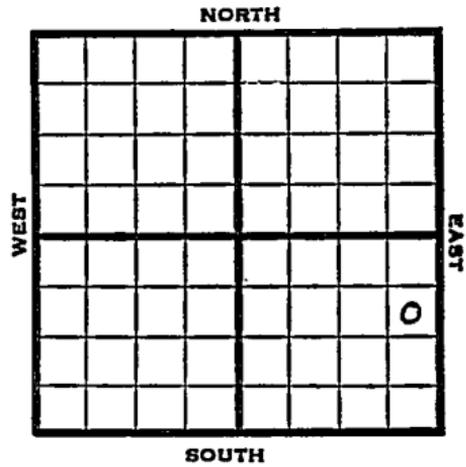

1951 Elev 1757' REPORT

1/10 8" @ 200
Heeb 2813 Br. Lime 2937
Lans 2960-3052 TD
DST 3044-52 opn 1 hr rec 10' o&gcm
5" @ 3044

2/14 Oil Well TD 3052
8" @ 200'
Heeb. 2813' Br Lime 2937' ✓
Lans. 2960-3052 TD
DST 3044-52 opn 1 hr.
Rec. 10' o & gcm
5" @ 3044 CO to 3052
2000 A S/30 bfph Comp. 60 bopd

COMPLETED

