


Section 16 Township 19 Range 10W

Well No. #3 Kleeper

Company C. E. Ash

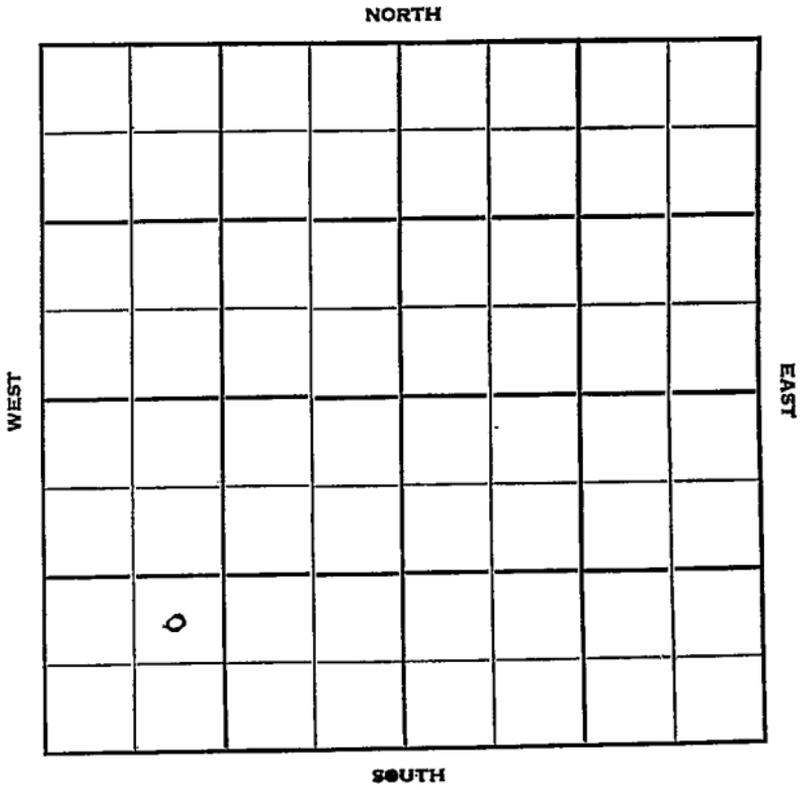

Sec. 16 Twp. 19 R. 10 W

Well No. # 3 Kleeper Farm

C. E. Ash Company

Contractor

Silica Pool


Ft. from N. Line

990 Ft. from S. Line

Ft. from E. Line

990 Ft. from W. Line

NE SW SW

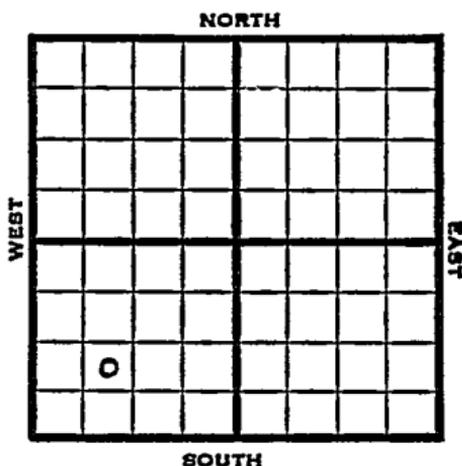

1951

Elev. 1763' REPORT

3/21

Location

6/5

Spud 3-21-51  
 D&A TD 3345  
 8" @ 216 Anhy 216  
 Anhy 465 Heeb. 2841  
 Tor. 2860 Br Lime 2961  
 Lans. 2987 Cong. 3270  
 Ch Cong. 3301  
 Arb. 3303 TD 3345  
 6" @ 3345 CO to 3338  
 16/3330-36 wtr SP 3326  
 8/3324-26 SP 3316  
 8/3317-19 8/3320-24  
 500 A wtr SP 3315  
 24/3303-09 wtr.  
 8/3322-24 500 A 1 bfph 1000A  
 SP 3312 24/3303-09 500 A 1 bfph  
 60% wtr SP 3160 24/3129-35 500 A  
 24/3070-75 500 A  
 D&A **ABANDONED**



