


Section 16 Township 19 Range 10-W

Well No. #4 Burnstorf

Company Ed Bradley (was Virginia Drlg.)

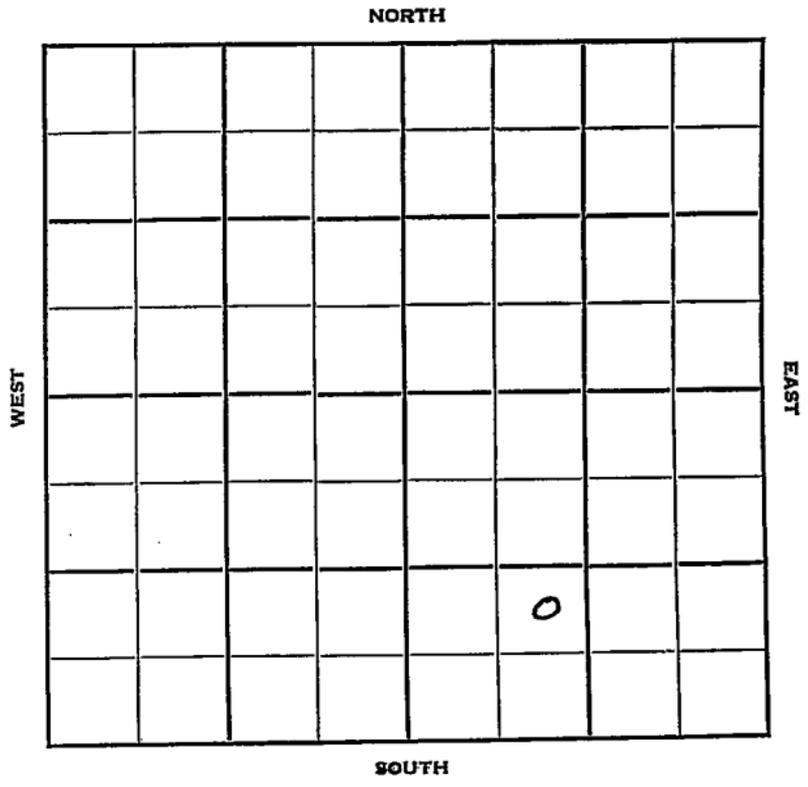

KANSAS

Rice

Sec. 16 Twp. 19 R. 10-W

Well No. #4 Brunstorf Farm

Ed Bradley (was Virginia Drlg.) Company

Virginia Drlg. Contractor

Silica


_____ Ft. from N. Line

990 Ft. from S. Line

_____ Ft. from E. Line

990 Ft. from W. Line

NE SW SE

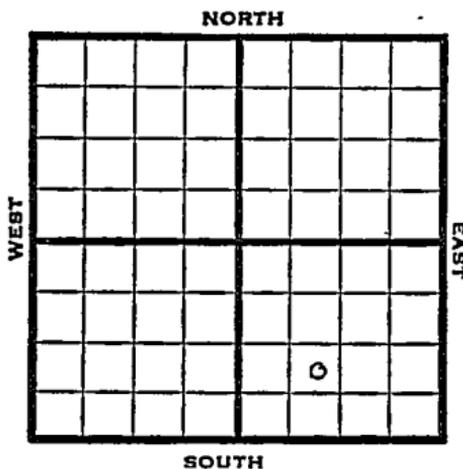

1950

Elev. 1763' REPORT

11/1

Spud 10-25-50
8 5/8" @ 195
Anhy 443
Drlg 2386

11/22

Spud 10-25-50
Oil Well TD 3117
8-5/8" @ 195'
Anhy 443' Lans. 2960'
DST 3045-60 opn 1 hr
Rec. 240' oil & mud
5" @ 3117 12/3051-55 500 A
Comp. 50 BOPD

COMPLETED

3


County Rice State Kansas

Sec. 16 (Blk. 19) (Sur. 10W) (Twp.) (Rge.) Map No.

Operator Ed Bradley (was Virginia Drlg.)

Well No. 4 Farm Burnstorf

Elev. Location NE SW SE

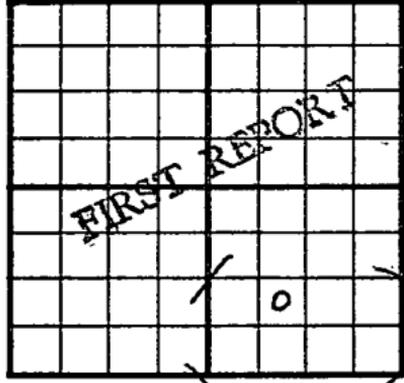

990 Ft. From S Line SE

990 Ft. From W Line Quarter

1st. Report NOV 1 1950

Completion


Remarks

Virginia Drlg. - Contr.

Spudding Date 10-25-50

Drlg. Data Silica Pool

8 5/8" @ 195 Anhy 443 drlg. 2386

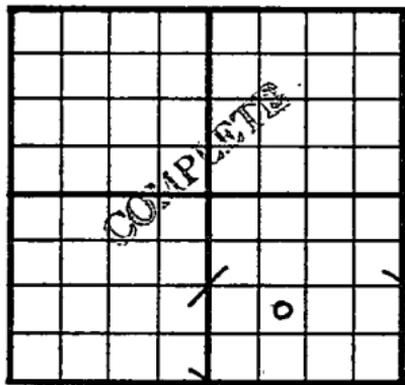County Rice State KansasSec. 16 (Blk. Twp.) 19 (Sur. Rge.) 10W Map No.Operator Ed BradleyWell No. 4 Farm BurnstorfElev. 1763 Location NE SW SE990ft. From S Line SE990ft. From W Line Quarter

1st. Report

Completion NOV 22 1950Remarks Silica PoolVirginia Drlg. - Contr.Spudding Date 10-25-50Drlg. Data Oil well TD 31178 5/8" @ 195 Anhy 443 Lans. 2960DS^T 3045-60 open 1 hr. Rec. 240' oil& mud 5" @ 3117 12/ 3051-55 500 AComp. 50 bond