

Section 16 Township 19 S Range 2 W

Well No. # 2 Unruh

Company Geo. Hess

NORTH

WEST

EAST

0

SOUTH

McPherson

KANSAS

SEC.	TWP.	R.
16	19S	2W

WELL NO.

#2 Unruh

FARM

COMPANY

Geo. Hess.

CONTRACTOR

Mallard Tools.

Ritz-Canton

Ft. from N. Line

990


Ft. from S. Line

990

Ft. from E. Line

Ft. from W. Line

NW SE SE

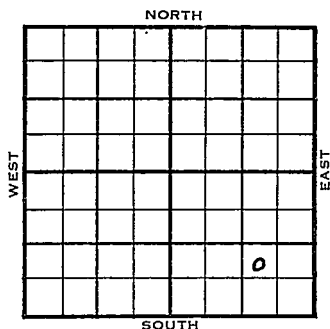

1954

ELEVATION

1552'

REPORT

12/8

8" @ 157'

WOR.

12/29

Spud 12-9-54

D & A

TD 3001'

8" @ 157'

KC 2324' Miss 2958'

TD 2979'

5" @ 2976'

DD 3001' SSO HFW PB 2940'


40/ 2930'-40' wtr. CO to 2940

24/ 2930'-36' FU 2000' SW.

D & A

ABANDONED

FABEN GILSTRAP

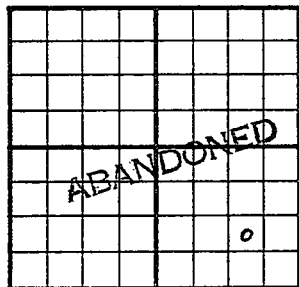County McPherson State KansasSec. 16 (Blk. Twp.) 19 (Sur. Rge.) 2W Map No.Operator Geo. HessWell No. 2 Farm UnruhElev. 1552 Location NW SE SE

990Ft. From S Line SE

990Ft. From E Line Quarter

1st. Report

Completion DEC 29 1954

Remarks Ritz-Canton Pool

Mallard - Contr.

Spudding Date 12-9-54

Drlg. Data D & A TD 3001

8" @ 157 KC 2324 Miss. 2958

TD 2979 5" @2976 DD 3001 SSO HFW

PB 2940 40/ 2930-40 wtr. CO to 2940

24/ 2930-36 FU 2000' sw

D & A

FABEN CII STRAP