


DX 78-1

Section 16 Township 19 Range 2W

Well No. #1 Unruh

Company Dr. G.E. Finkel (McPher)

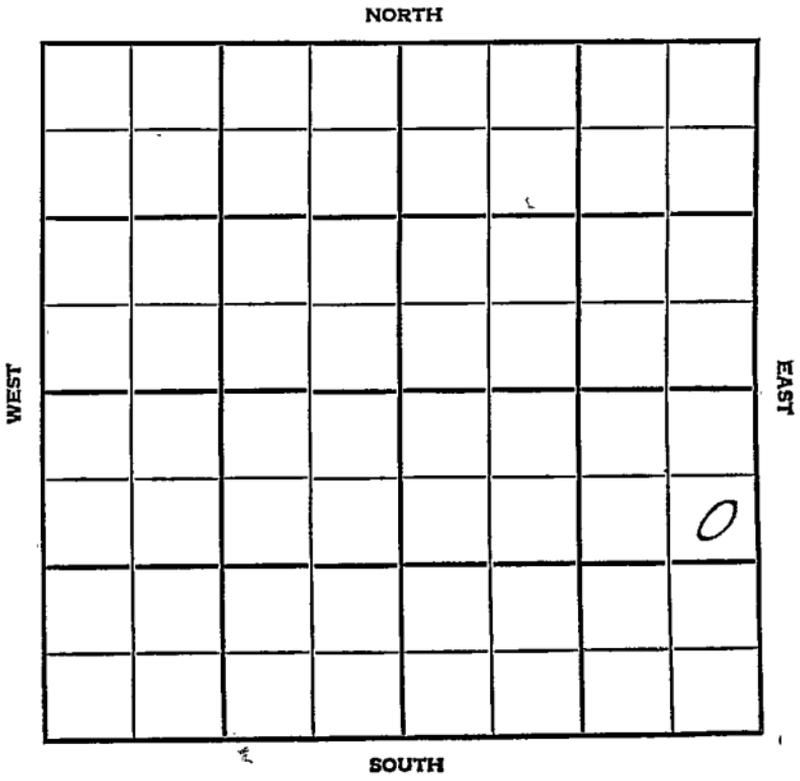

County McPherson Elev. _____
 Sec. 16 Twp. 19 Rge. 2W
 Company Dr. G.E. Finkel (McPher)
 FarmName Unruh No. 1

TOPS	DEPTH	LOG	DATUM	Loc. in Sec.
Anh.				SE NE SE
Tr.				
H.				
Tr.				
Dg.				
Bl.				
L.				Geol. _____
K.C.				Contr. _____
B.K.C.				Mallard Tools
Ce.				
C.				Pool
M.				GALVA
M.				
K.				
Mz.				
Ma.				
V.				
S.				
S.				
A.				
R.				FIRST REPORT
PE.				
G.				
T.D.				

Date Comm. 11-2-5 6
8" @ 150 w/110, Drlg. 1975

(Handwritten scribble)

Co.
No.
Sec.
T.
R.

County McPherson Elev. 1551 DF
 Sec. 16 Twp. 19 Rge. 2W
 Company Dr. G.E. Finkel (McPh)
 Farm Name Uhruh No. 1

Co.

TOPS	DEPTH	LOG	DATUM
Anh.			
Tr.			
H.			
Tr.			
Dg.			
Bl.			
L.	<u>2316</u>		
K.C.			
BXC.			
Ce.			
C.	<u>2946</u>		
M.	<u>2952</u>		
M.			
K.			
Mz.			
Mo.			
V.			
S.			
S.			
A.			
R.			
PE.			
G.			
TD.	<u>2954</u>		

Lot. in Sec. SE NE SE
 Geol. _____
 Contr. Mallard Tool
 Pool GALVA

1st

COMPLETE
 DEC 20 1956

No.

Date Comm. 11-2-56

8" @ 150 w/110, Drig. 1975 DEC 12 '56 5 1/2

@ 2953/105 DEC 19 '56 co DD 2965

1/2 DD 2999 TD test 1 B0 +

2 Buph PB 2340 30/2324-30

2 1/2 @ 14 Bopd no/w 4 hrs

est P. 25 Bopd no/w

Sec.

T.

R.