


McPherson

Section 16 Township 19 Range 2W

Well No. ~~#3~~ <sup>#4</sup> Koehn

Company Petrey & Krebbs

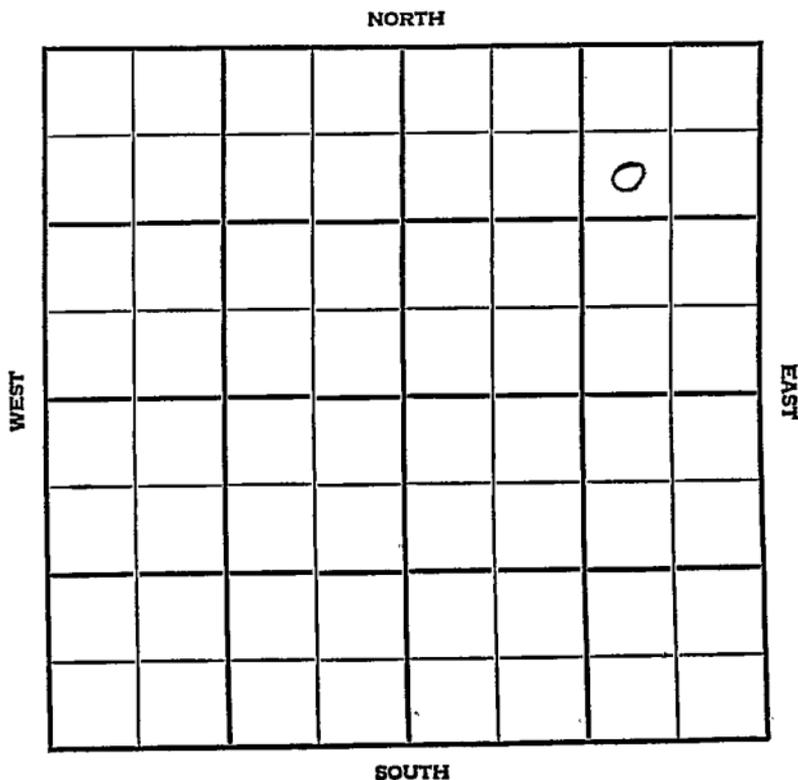

SEC.	TWP.	R.
16	19	2W

WELL NO. **#4**  
~~3~~ Koehn

COMPANY FARM  
 Petrey & Krebs

CONTRACTOR  
 Carey

Ritz-Canton Pool


990' 940 Ft. from N. Line

Ft. from S. Line

840' Ft. from E. Line

Ft. from W. Line

SW NE NE

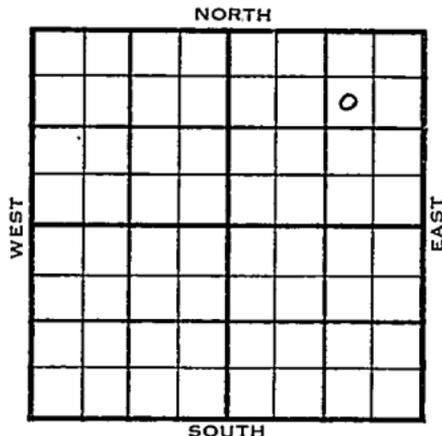

1955	ELEVATION	REPORT
	1545	

6/1 M I R  
 7/13 Comm. 6-12-55  
 8-5/8" @ 151/80  
 DST 2321-28 open 23 min, rec 600' gas  
 120' oil, 55' OCM, 15' wtr. 595#  
 5 1/2" @ 2945 DD 2951 500 A  
 S/8 GO 75 GWPH 1 hr. FU 225' fluid  
 16 hr. 60' oil. B/30 GO 32 GWPH  
 PB 2371 Perf/2322-28 100 A  
 S/8 BOPH FU 1065' oil 50' wtr.  
 S/8 BOPH 1/4 hr.  
 Comp. 40 BOPD 10 BW  
 KC 2315', G 2937', M. 2942'  
 TD 2949'

**COMPLETED**



SCOUT TICKET DX-201

Kansas

SEC. 16	TWP. 19	R. 2W
------------	------------	----------

WELL NO.

4 Koehn

FARM

COMPANY

Petrey & Krebs

CONTRACTOR

CORRECTION


SW NE NE

940 FT. FROM N. LINE

FT. FROM S. LINE

840 FT. FORM E. LINE

FT. FROM W. LINE

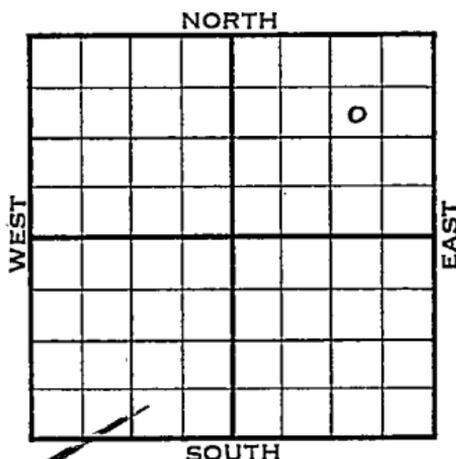

McPherson County

LOCATION

RIG UP

DRILLING AND REMARKS:

Reported  
#3 Koehn

RECORD

CASED IN.. FT.

SAND

GAS

OIL

TOTAL DEPTH

1ST 24 HRS. NAT.

1ST 24 HRS. AFTER SHOT

GAS CU. FT.

DRY HOLE

ABANDONED

PRODUCTION

DATE

JUN 15 1955

SCOUT

*L.D. Harris*

