

Section 16 Township 19 Range 14WWell No. #1 OtteCompany Marmad Oil

NORTH

				0			

WEST

EAST

SOUTH

KANSAS ✓

Sec. 16 Twp. Barton 19 R. 14W

Well No. #1 Otte Farm

Marmad Oil Company

Flemming & Woodman - Contr. Contractor
Wildcat


990' Ft. from N. Line

 Ft. from S. Line

 Ft. from E. Line

330' Ft. from W. Line

SW NW NE

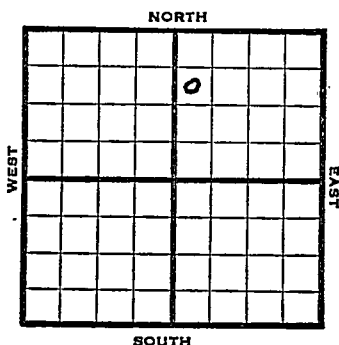


1952	Elev. 1898' REPORT
7/16	Spud 7-14-52 8" @ 839 WOC
7/23	Anhy 847' Drlg. 3045'
7/30	Spud 7-14-52 D & A TD 3560' 8" @ 839 Anhy 847' Lans. 3248' Cong. 3472 DST 3470-3510 open 20 min, rec 10' mud 250# Arb. 3547' TD 3560' D & A
	ABANDONED

8TH 839 WOC

J. G. McGEHEE

County Barton State Kansas
 Sec. 16 (Blk.) 19 (Sur.) 14W Map No.
 Operator Marmad Oil
 Well No. 1 Farm Otte
 Elev. 1898 Location SW NW NE

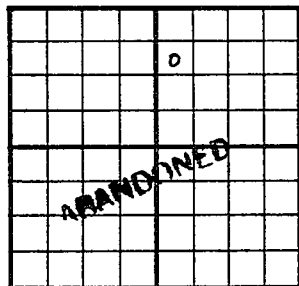

990 Ft. From N Line NE
330 Ft. From W Line Quarter
 Ist. Report
 Completion JUL 30 1952
 Remarks Wildcat
Flemming & Woodman - Cont
 Spudding Date 7-14-52

Drilg. Data D & A TD 3560
8" @ 839 Anhy 847 Lans. 3248
Cong. 3472 DST 3470-3510 open 20 min.
Rec. 10' mud 250# Arb. 3547 TD 3560
D & A