DX 78-1


Barton

KANSAS

Section 16 ~ Township 19 Range 14 W

Well No. #1 Essmiller "E"

Company Petroleum Inc.

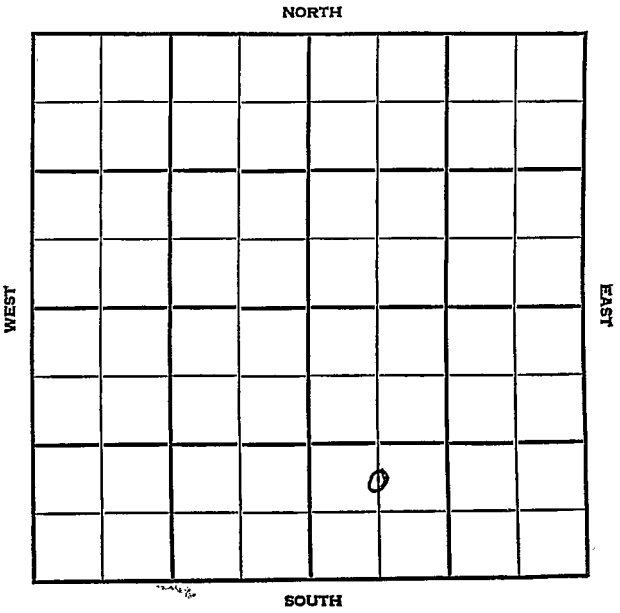

Barton KANSAS

SEC.	TWP.	R.
16	19	14W

WELL NO.

#1 Espmiller "E" FARM

COMPANY

Petroleum Inc.

CONTRACTOR

Garvey

Heizer


_____ Ft. from N. Line

_____ Ft. from S. Line

_____ Ft. from E. Line

_____ Ft. from W. Line

C N½ SW SE

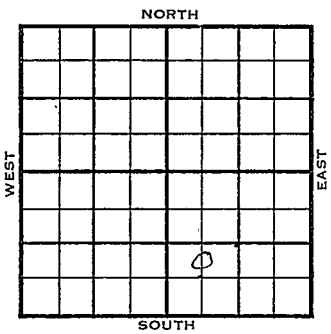

1956	ELEVATION REPORT
2-8	Comm. 2-4-56 8" @ 825/400 Drlg. 2190

DX-78

FORM 513 REV. SUNRAY

County Barton Elev.

Sec. 16 Twp. 19 Rge. 14W

Company Petroleum Inc.

Farm Name Essmiller "E" No. 1

TOPS	DEPTH	LOG	DATUM
Anh.			
Tp.			
H.			
Tr.			
Dg.			
Bl.			
L.			
K.C.			
B.K.C.			
Ce.			
C.			
M.			
M.			
K.			
Mz.			
Mo.			
V.			
S.			
S.			
A			
R.			
P€.			
G.			
T.D.			

Loc. in Sec. C N½ SW SE

Geol.

Contr. Garvey

Pool Heizer

FIRST REPORT

FEB 8 '56

o

Date Comm. 2-4-56

8" @ 825/400 drlg. 2190

Co. Lse. No. Sec. T. R.

FORM 513 REV. SUNRAY

County Barton Elev. 1894

Sec. 16 Twp. 19 Rge. 14W

Company Petroleum Inc.

Farm Name Eggmiller "E" No. 1

TOPS	DEPTH	LOG	DATUM
Anh.	815		
Tp.			
H.	3130		
Tn.			
Dg.			
Bl.	3317		1323
L.	3231		1237
H.C.			
B.K.C.	3458		1564
Ce.	3482		1588
C.			
M.			
M.			
K.			
Ne.			
Mo.			
V.			
S.			
S.			
A	3578		1684
R.			
Pe.			
G.			
TD	3596		

Loc. in Sec. C N½ SW SE

Geol.

Cente Garvey

Pool Heizer

ABANDON

FEB 15 1956

Date Comm. 2-4-56

8" @ 825/100 drlg. 2190 FEB 15 56 DST 3234-56 30" rec 20' Md BHP 0/20 DST 3376-3416 30" rec 10' Md BHP 0/20 DST 3496-3508 1hr rec 63' OSGCM BHP 625/20 DST 3518-35 OR 45 rec 15' Md BHP 0/20" DST 3580-96 1hr rec 1440' SW BHP 1000/20 DST 3430-3

FEB 27 1956

R. G.