


Section 16 Township 19 Range 14-W

Well Number 1 Essmiller

Company Morgant Flynn et al

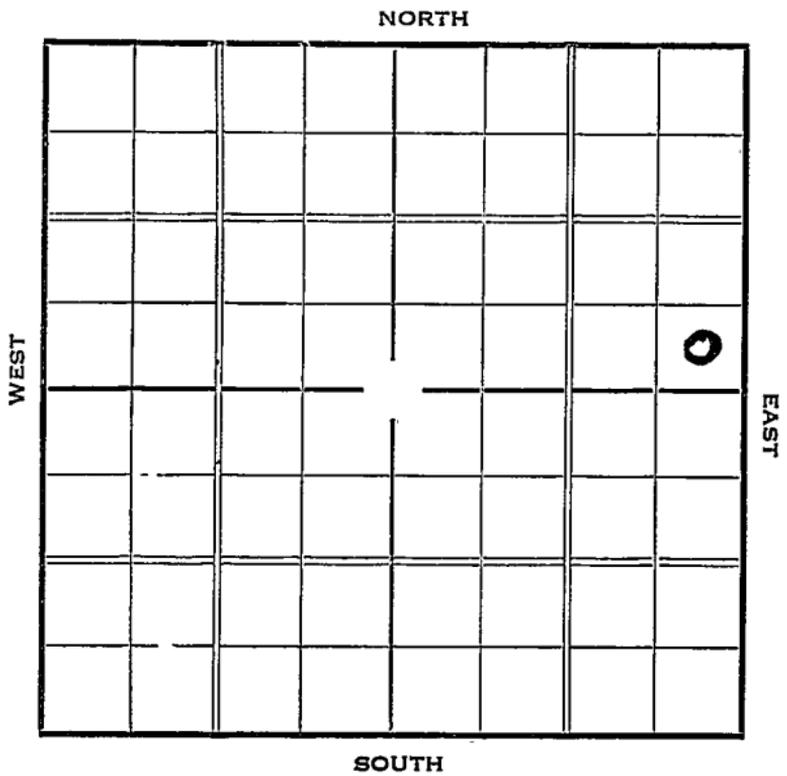



1937

6/16 Sil. 3643' (Corrected)

Granite Wash 3745'.

T.D. 3748'.

**ABANDONED**

Map No. 82 Sec. 16 Twp. 19 R. 14WWell No. 1 EssmillerMorgan & Flynn et al. Company  
Contractor**Special****SECTION PLAT**       Ft. from N. Line330 Ft. from S. Line330 Ft. from E. Line       Ft. from W. Line

			0

**FIRST REPORT**Location ✓Rig up       

Drilling and Remarks:

**RECORD**Cased        in.,        ft.Sand       Gas       Oil       Total Depth       **PRODUCTION**1st 24 hrs. Nat.       1st 24 hrs. after shot       Gas        Cu. Ft.Dry Hole       Abandoned       

Date

MAR 24 1937 19

S. J. LEWIS

Scout

*Barton* KANSAS

Map No. *82* Sec. *16* Twp. *19* R. *14*<sup>W</sup>

Well No. *1 - Essmiller*

*Morgan & Flynn et al* Company

Contractor

ABANDONED

SECTION PLAT

			0

\_\_\_\_\_ Ft. from N. Line

*530* Ft. from S. Line

*330* Ft. from E. Line

\_\_\_\_\_ Ft. from W. Line

Location \_\_\_\_\_

Rig up \_\_\_\_\_

Drilling and Remarks:

*D&A*

RECORD

Cased \_\_\_\_\_ in., \_\_\_\_\_ ft.

Sand *511 3643*

~~Gas~~ *(corrected)*

~~Oil~~ *Granite wash 3745*

Total Depth *3748*

PRODUCTION

1st 24 hrs. Nat. \_\_\_\_\_

1st 24 hrs. after shot \_\_\_\_\_

Gas \_\_\_\_\_ Cu. Ft.

Dry Hole \_\_\_\_\_

Abandoned \_\_\_\_\_

Date

**JUN 16 1937** 19

**H. D. Hatfield**

Scout