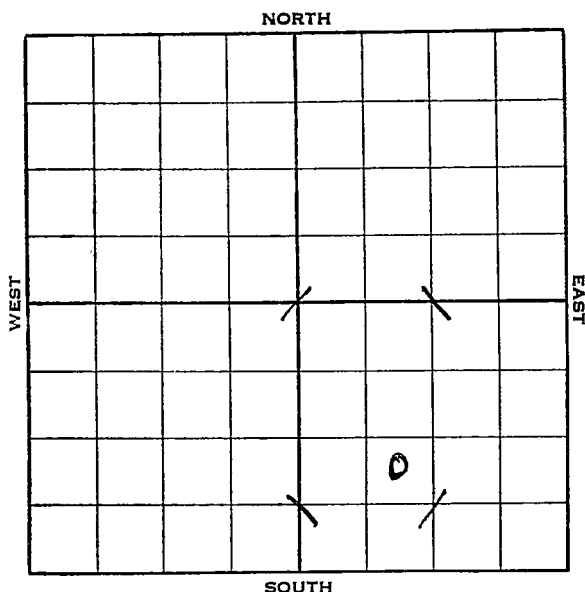


Barton

KANSAS


Section 16 Township 19 Range 14-WWell No. 1 EssmillerCompany J. A. Rankin

KANSAS

Barton

Sec. 16 Twp. 19 R. 14-WWell No. #1 Essmiller FarmJ. A. Rankin Company Ft. from N. Line990 Ft. from S. Line Ft. from E. Line990 Ft. from W. Line

Elev. 1893

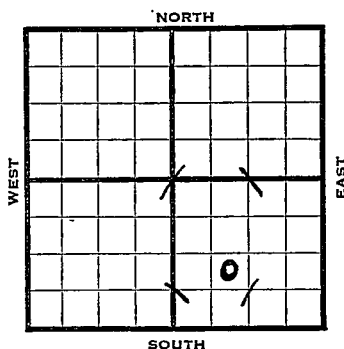

1938	REPORT
5/4	Machine.
5/12	20" @ 58'. Drlg. 120'.
5/20	15" @ 310'. WOC.
5/27	SD 435'.
6/3	" "
6/10	" "
6/17	SD 835'.
6/24	Anhy 815'. 13" - 823'.
	Drlg. 900'.
7/1	S.D. 1545'
7/8	10" - 2117'. Cleaning out.
7/15	10" - 2131'. T. D. 2140'. U. R.
7/22	SD 2210'.
7/29	" "
8/5	" "
8/12	" "
8/19	10" - 2161'. TD 2427' SD.
8/26	8" - 2427'. Dlg. 2500'.
9/2	Topeka 2780'. 3 B.W. 2945-50'.
	Dlg. 3150'.
	OVER

1938

9/9 Lans. 3220'. 7" - 3220'.
H.F.W. 3305-15' SD.

9/16 SD 3315'.

9/23 " "

9/30 T. D. 3327' SD.

10/7 Dlg. 3340'.

10/14 7" - 3325'. 7" - 3342'.
Cong. 3455'. T.D. 3495'.
S.S. G. Fsg.

10/21 Gas 3495-3502'.

Est. 7 M gas & S.S.O.

10/28 Killed gas. Deepened to 3520' TD
Spray oil. Shut down.

11/4 " " " "

11/12 SD 3520' TD.

11/18 " "

11/25 " "

12/2 P. B. 3437'.

12/9 5" - 3425'. Dlg. 3453'.

12/15 S.D. 3467'.

12/23 Drlg. 3480'.

12/30 Gas 3490-96 in Cong.
Fsg. bailer.

1939

1/6 " " "

1/13 T. D. 3517'. Rng. 4" liner.

1/20 T. D. 3519'. Rng. liner.

1/27 111' of 4" liner @ 3519'. C.O.

OVER

1939
 2/3 Drlg. 3533'.
 2/10 T. D. 3550' in Cong.
 Will perf.
 2/17 Perf. 76 shots 3492-3527'.
 269,000 gas. S.D.O.
 2/23 " " " "
 3/3 600' oil in 1 week
 Will shoot.
 3/10 " " " "
 3/17 TD 3550' SD.
 3/24 Shot 40 qts. 3485-3507'.
 T.D. 3550'.
 3/31 Cleaning out.
 4/7 " " " "
 4/12 5" - 3425'.
 Cong. 3455'.
 T. D. 3550'.

ABANDONED

Map No. 82 Sec. 16 Twp. 19 R. 14WWell No. 1 EssmillerJ. A. Rankin Company

Contractor

FIRST REPORT

NE SW SE


Ft. from N. Line

990 Ft. from S. Line

Ft. from E. Line

990 Ft. from W. Line

SECTION PLAT

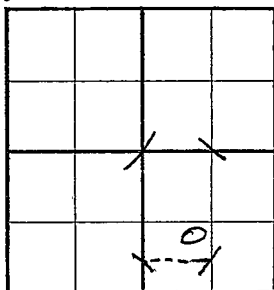

Location _____

Rig up _____

Drilling and Remarks:
Mach.

RECORD

Cased _____ in., _____ ft.

Sand _____

Gas _____

Oil _____

Total Depth _____

PRODUCTION

1st 24 hrs. Nat. _____

1st 24 hrs. after shot _____

Gas _____ Cu. Ft.

Dry Hole _____

Abandoned _____

Date

MAY 4 - 1938 19 H. D. Hatfield Scout

Barton

KANSAS

Map No. 82 Sec. 16 Twp. 19 R. 14WWell No. 1 EssmillerJ. A. Rankin

Company

Contractor

ABANDONED

NE SW SE

 Ft. from N. Line990 Ft. from S. Line Ft. from E. Line990 Ft. from W. Line

SECTION PLAT

		0	

WILDCAT

Location Rig up

Drilling and Remarks:

RECORD

Cased 5 in., 3425 ft.Sand cong 3455Gas Oil Total Depth 3550

PRODUCTION

1st 24 hrs. Nat. 1st 24 hrs. after shot Gas Cu. Ft.Dry Hole Abandoned

Date

APR 12 1939

19

H. D. Hatfield

Scout