
Barton

FORM 51 5M BRIX KANSAS

Section 16 Township 19 Range 15W

Well No. #1, Saylor

Company Helmerich & Payne

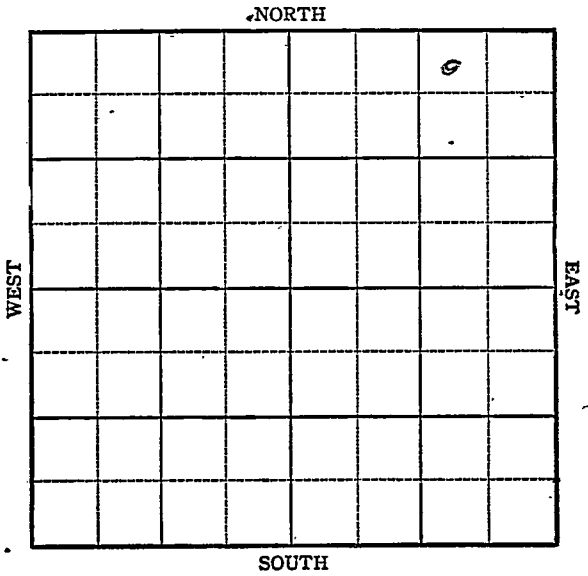

FORM 252-A
5M 3-44 PETROL

KANSAS

Barton

Sec. 16 Twp. 19 R. 15W

Well No. #1. Saylor Farm


Helmerich & Payne Company

330 Ft. from N. Line

Ft. from S. Line

990 Ft. from E. Line

Ft. from W. Line

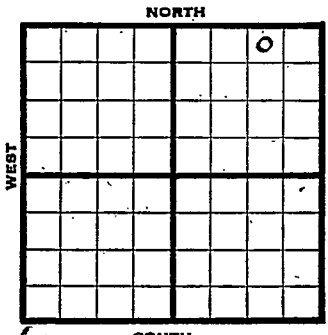

Elev. 1942

1944	REPORT
6/7	Drlg. 597'
6/15	Anhy. 909 10" @ 912 Drlg. 2157'
6/21	Drlg. 3250
6/28	Regan 3559 SO TD 3586 5" @ 3561 RUST
7/12	Regan 3559 5" @ 3561 Water TD 3587

ABANDONED

FORM CAS-200 BKS. 2-44 PETROL

KANSAS

Pool Name Merten

Map No. 52 Sec. 16 Twp. 19 R. 15W


Well No. 1 Saylor

Helmerich & Payne Company

FIRST REPORT Contractor

NW NE NE

SECTION PLAT

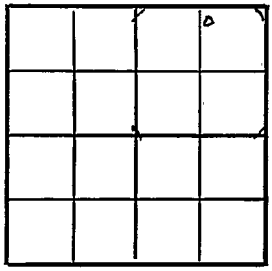

330 Ft. from N. Line

Ft. from S. Line

990 Ft. from E. Line

Ft. from W. Line

Barton County

Location

Rig up

Drilling and Remarks:

597

RECORD

Cased in., ft.

Sand

Gas

Oil

Total Depth

PRODUCTION

1st 24 hrs. Nat.

1st 24 hrs. after shot

Gas Cu. Ft.

Dry Hole

Abandoned

Date

JUN 7 1944 19

S. J. LEWIS Scout

FORM 26 200 BKS. 2-44 PETROL

KANSAS

Pool Name Merten

Map No. 82 Sec. 16 Twp. 19 R. 15W


Well No. 1 Saylor

Helmerich & Payne Company

ABANDONED Contractor

NW NE NE

SECTION PLAT

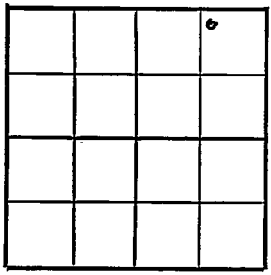

330 Ft. from N. Line

Ft. from S. Line

990 Ft. from E. Line

Ft. from W. Line

Barton County

Location

Rig up

Drilling and Remarks:

Reagan 3539
3561
Water

RECORD

Cased in., ft.

Sand

Gas

Oil

Total Depth 3587

PRODUCTION

1st 24 hrs: Nat.

1st 24 hrs. after shot

Gas Cu. Ft.

Dry Hole

Abandoned

Date

JUL 12 1944 19

S. J. LEWIS Scout