


DX 78-1

Rush KANSAS

Section 16 Township 19 Range 20W

Well No. 3 Webs "C"

Company Republic Nat. Gas & Natural G&O

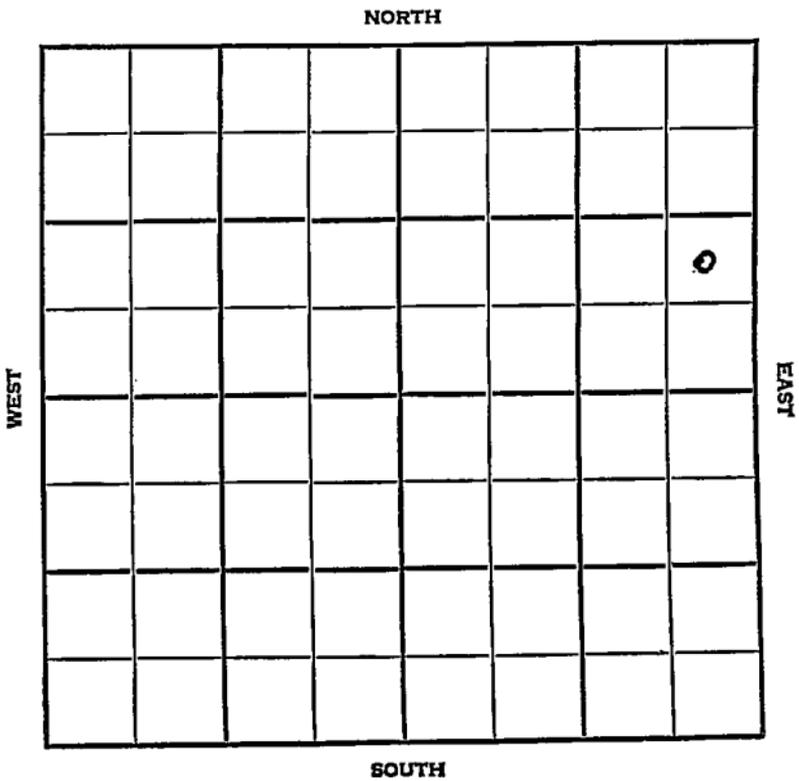

Rush

KANSAS

SEC.	TWP.	R.
16	19	20 W

WELL NO.

3 Webs "C"

FARM

COMPANY

Republic Nat. Gas & Natural G & O

CONTRACTOR

Webs Pool

NORTH

_____ Ft. from N. Line

990 _____ Ft. from S. Line

330 _____ Ft. from E. Line

_____ Ft. from W. Line

NE SE NE

							0

SOUTH

ELEVATION

1955 ~~1550~~ / 2202 REPORT

2/23 Spud 2-17-55
8" @ 190
Dr lg. 2530'

~~4/6 Spud 2-13-55, Oil Well, TD
2953, 8" @ 165, Lans 2323,
DST 2325-43 open 1 hr. Rec 10'
mud 70# Miss 2941, TD 2953, 5"
@ 2944 CO to 2953, PU 200' oil
3 hr frac S/7 BOPH 8 hr,
Comp 35 BOPD 15 BW *rrr*~~

4/6 Spud 2-17-55, Oil Well, TD 4300
8" @ 190, Heeb 3694, Lans 3738
Cherokee 4207, DST 4205-22
open 1 hr Rec 2990' SW, 180'
O&GCSW, 1305# TD 4300 5" @
4298 CO 20/4207-12
S/25 B0 plus 75 load 6 hr
Comp 140 BOPD

COMPLETED

