


Section 16 Township 19 Range 20W

Well No. #1 J. Williams "B"

Company Natural Gas & Oil

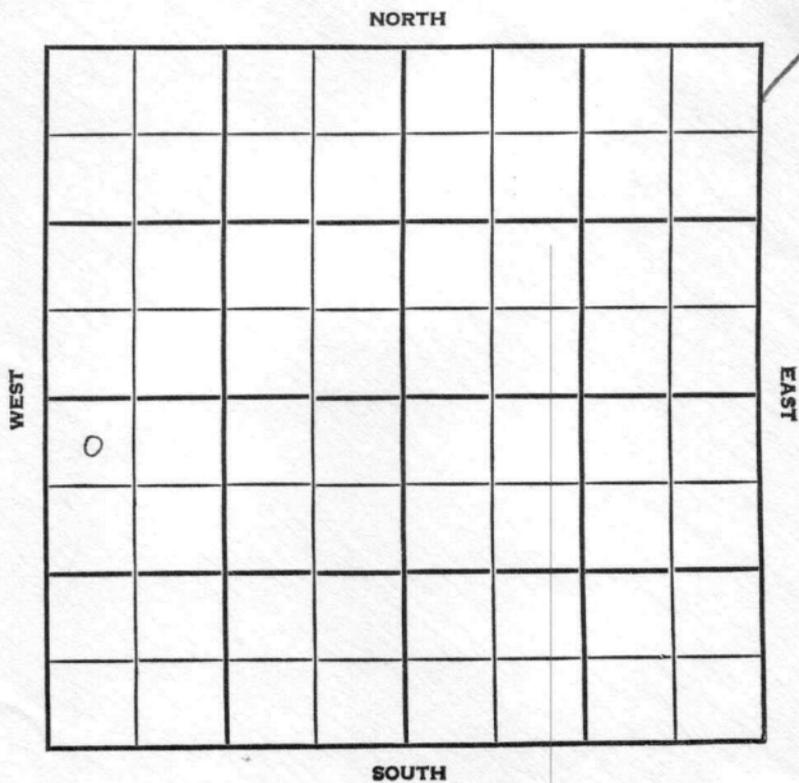



County Rush Elev. \_\_\_\_\_  
 Sec. 16 Twp. 19 Rge. 20W  
 Company Natural Gas & Oil  
 Farm Name J. Williams "B" No. 1

TOPS	DEPTH	LOG	DATUM
Anh.			
Tp.			
H.			
Tr.			
Dg.			
Bl.			
L.			
K.C.			
B.K.C.			
Ce.			
C.			
M.			
M.			
K.			
Mz.			
Me.			
V.			
S.			
S.			
A.			
R.			
Pe.			
G.			
T.D.			

Loc. in Sec. NW NW SW  
 Geol. \_\_\_\_\_  
 Contr. Lewis  
 Pool Webs



Date Comm. 7-13-56 JUL 18 '56  
8" @ 553/300 d rlg. 2500

\_\_\_\_\_  
 \_\_\_\_\_  
 \_\_\_\_\_  
 \_\_\_\_\_  
 \_\_\_\_\_  
 \_\_\_\_\_  
 \_\_\_\_\_

Co.  
 Lse.  
 No.  
 Sec.  
 T.  
 R.

JUL 2 1956  
 R. C.

County Push Elev. 2254  
 Sec. 16 Twp. 19 Rge. 20W  
 Company Natural Gas & Oil  
 Farm Name J. Williams "B" No. 1

TOPS	DEPTH	LOG	DATUM
Anh.			
Tr.			
H.	<u>3770</u>		
Tr.			
Dg.			
Bl.			
L.	<u>3818</u>		
K.C.			
B.K.C.			
Ce. <u>sd</u>	<u>4286</u>		
C.			
M.	<u>4375</u>		
M.			
K.			
Mz.			
Me.			
V.			
S.			
S.			
A.			
R.			
Pe.			
G.			
TD.	<u>4395</u>		

Loc. in Sec. \_\_\_\_\_

Geol. \_\_\_\_\_

Contr. \_\_\_\_\_

Lewis

Pool \_\_\_\_\_

Webs

COMPLETE

AUG 29 1956

Date Comm. 7-13-56

8" O 553/300 1 rls. 2500 JUL 25 '56

Circ @ 4290 AUG 1 '56 DST 4285  
-95 lbr 25' Md BHP 180/20"  
DST 4285-4315 lbr 720'  
50 & GCM + 1440' 9554 oil  
1260/20" 5 1/2 @ 4390

AUG 6 '56 CO 8/4303-05 50 &

88 B0 + 116 BW 15 hrs 50d.

CO 4325 8/4314-16 B 5 GWRK

8/4302-04 \$ 10 B0 + 23 BW

7 hrs T&amp;R AUG 15 '56 P. 11.69

B0 + 50 BW 16 hrs

P. 58 B0 + 33 BW 24 hrs

AUG -- '56 X WO Pot. AUG 29 '56 Ph P.

59 B0 pd + 38% wt

grow 38°