


Section 17 Township 19 Range 11-W

Well No. #2 Hammeke

Company E. H. Adair

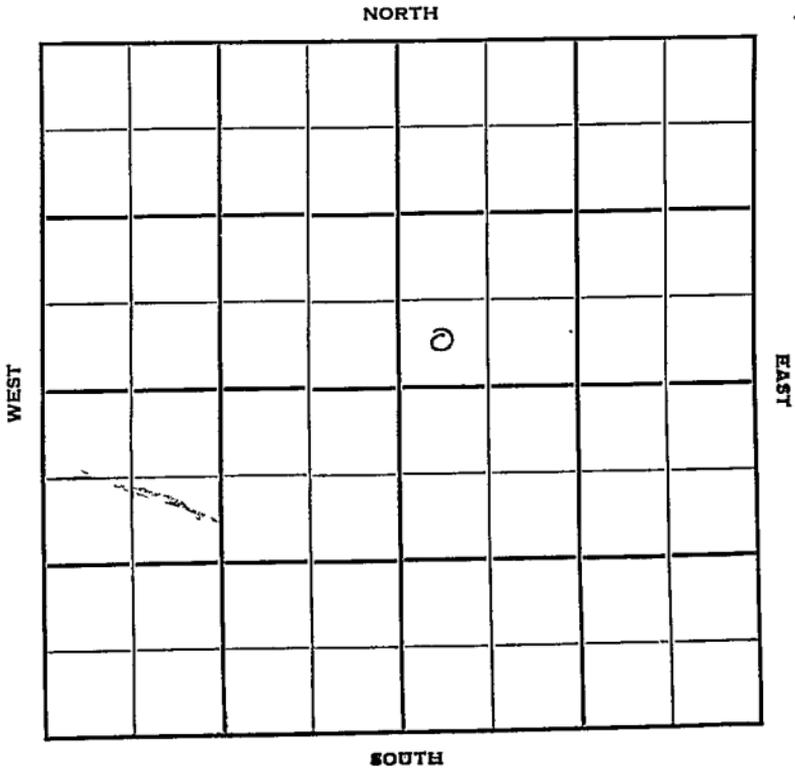

Sec. 17 Twp. 19 R. 11W

Well No. #2 Hammeke Farm

E. H. Adair Company

Adair - Contr. Contractor


_____ Ft. from N. Line

330' Ft. from S. Line

_____ Ft. from E. Line

330' Ft. from W. Line

SW SW NE

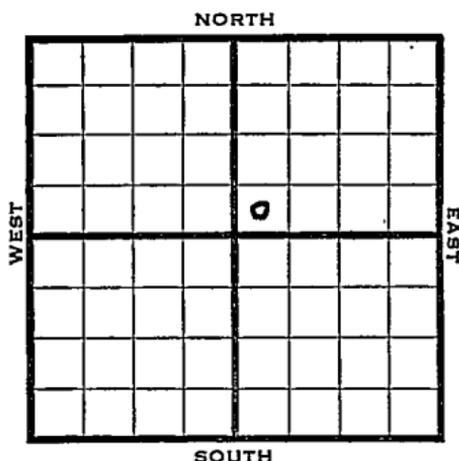

1950 Elev. 1772' REPORT

8/23 RUR

10/18 Spud 8-25-50

Oil Well TD 3372'
 8" @ 185' Heeb. 2934'
 Br Lime 3054' Lans. 3070'
 DST 3062-3101 opn 25 min.
 Rec. 60' gas 60' gas cut mud 120' oil
 & gas cut mud 120' wtr
 DST 3155-83 opn 1/2 hr
 Rec. 60' gas 45' GCM
 Cong. 3336 Ch.Cong. 3354'
 TD 3364' 5" @ 3355'
 TD 3372' SSO PB 3250'
 23/3232-40 SP 3200
 24/3166-74 24/3150-55
 1000A FU 600' wtr PB 3130
 6/3090-92 S/2 1/2 BOPH 500 A
 Comp. 75 BOPD 32% wtr.

COMPLETED

