


KANSAS

Barton

Section 17 Township 19 Range 11-WWell No. #2 Hammeke "A"Company Adair, Aledo etal

NORTH

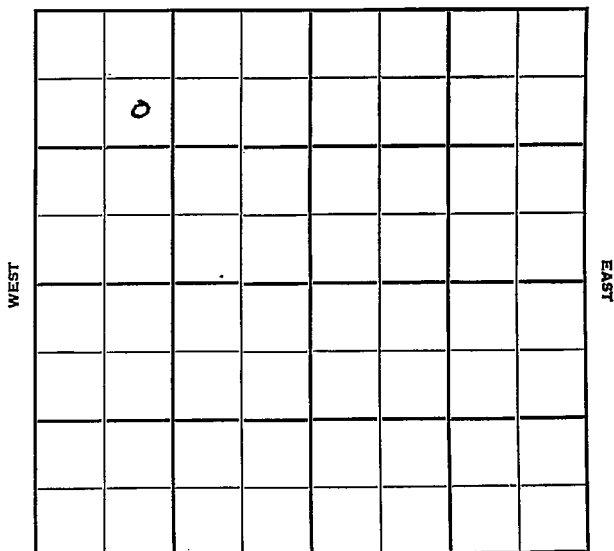

SOUTH

Sec. 17 Twp. 19 R. 11W

Well No. #2 Hammeke "A" Farm

Adair, Aledo et al Company

Adair - Contr. Contractor

Silica Pool

NORTH


990' Ft. from N. Line

Ft. from S. Line

Ft. from E. Line

990' Ft. from W. Line

SE NW NW

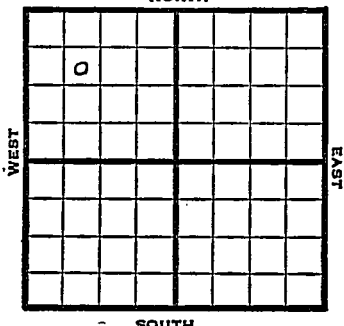

1950

Elev 1772'

REPORT

11/1' Spud 10-25-50

8" @ 227'

Anhy 585-60

Drlg. 2591'

11/15' 8" @ 227'

Anhy 585-60

Lans 3077

DST 3101-09 open 1 hr rec 45' mud

Cong 3347-78

Arb 3389

TD 3400

5" @ 3182

24/3098-3104

500 A

FU 500' water in 3 days

500 A

D&A

ABANDONED

County Barton State Kansas
 Sec. 17 (Blk. Twp.) 19 (Sur. Rge.) 11W Map No.
 Operator Adair, Aledo et al.
 Well No. 2 Farm Hammeke "A"
 Elev. 1772 Location SE NW NW

0							

990 Ft. From N Line NW

990 Ft. From W Line Quarter

1st. Report NOV 1 1950

Completion

Remarks

Adair - Contr.


Spudding Date 10-25-50

Drlg. Data

Silica Pool

8" @ 227 Anhy 585-60 drlg. 2591

J. E. TYRA

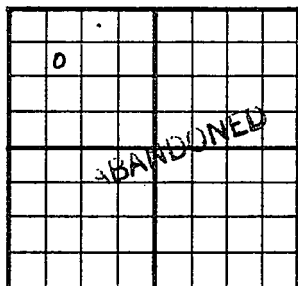County Barton State KansasSec. 17 (Blk.
Twp.) 19 (Sur.
Rge.) 11W Map No.Operator Adair, Aledo et al.Well No. 2 Farm Hammeke "A"Elev. 1772 Location SE NW NW990 Ft. From N Line NW990 Ft. From W Line Quarter

1st. Report

Completion NOV 15 1950Remarks Silica PoolAdair - Contr.Spudding Date 10-25-50Drlg. Data D & A TD 34008" @ 227 Anhy 585-60 Lans. 3077DST 3101-09 open 1 hr. Rec. 45' mudCong. 3347-78 Arb. 3389 TD 34005" @ 3182 24/ 3098-3104 500 AFU 500' water in 3 days 500 AD & A