

Section 17 Township 19 Range 11W

Well No. #2 Birzer

Company Honaker Drlg.

NORTH


WEST

EAST

SOUTH

*Q*

Sec. 17 Twp. 19 R. 11W ✓

Well No. #2 Birzer Farm

Honaker Drlg. Company

Honaker Drlg. - Contr. Contractor

Hammeke Pool


990' Ft. from N. Line

\_\_\_\_\_ Ft. from S. Line

\_\_\_\_\_ Ft. from E. Line

990' Ft. from W. Line

SE NW SE

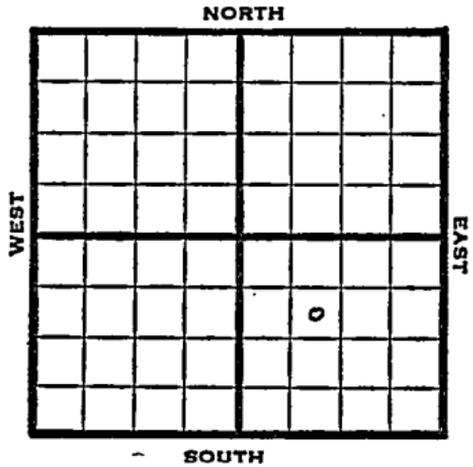

1950 Elev. 1785' REPORT

10/25 Spud 10-20-50  
8-5/8" @ 246'  
Drlg. 1967'

1951  
1/3 Spud 10-20-50  
Oil Well TD 3375  
8-5/8" @ 246' Top 2729  
KC 3076 Cong. 3351  
TD 3375 5" @ 3289  
GO to 3274 12/3250-53 12/3253-56  
Test wtr 500 A S/10 bo 1 hr  
7 bo 2 hr Comp. 291 bopd 2% wtr.

COMPLETED

County Barton State Kansas

Sec. 17 (Blk. Twp.) 19 (Sur. Rge.) 11W Map No.

Operator Honaker Drlg.

Well No. 2 Farm Birzer

Elev. Location SE NW SE


990 Ft. From N Line SE

990 Ft. From W Line Quarter

1st. Report OCT 25 1950

Completion

Remarks

Honaker Drlg. - Contr.

Spudding Date 10-20-50

Drlg. Data Hanneke Pool

8 5/8" @ 246 drlg. 1967

