


Section 17 Township 19 Range 11 W

Well No. # 2 Birzer

Company Lario Oil

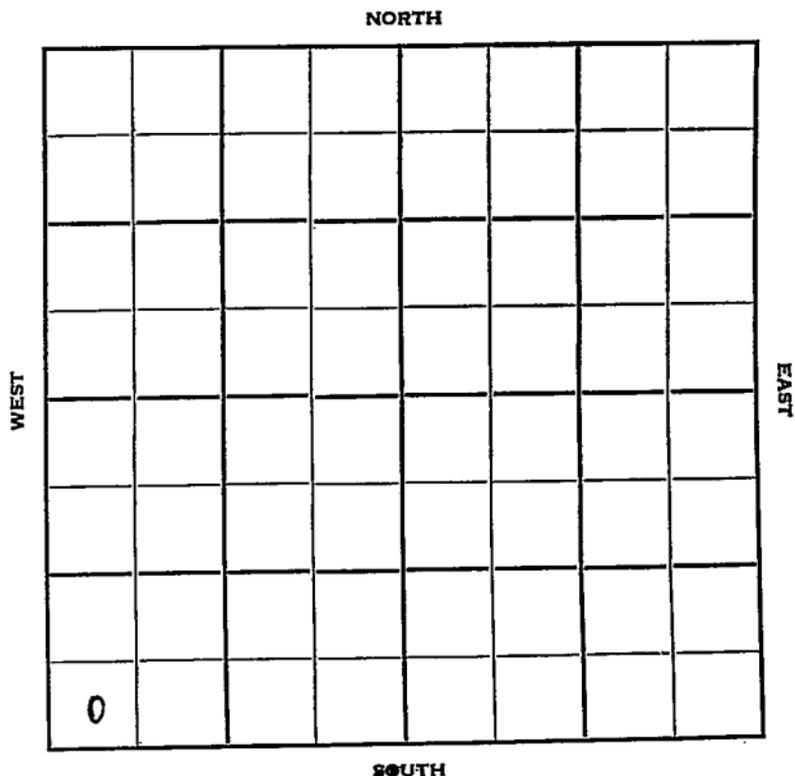

Barton

KANSAS

Sec. 17 Twp. 19 R. 11 W

Well No. # 2 Birzer Farm

Lario Oil Company

Sterling Contractor

Hammeke Pool


_____ Ft. from N. Line

330 Ft. from S. Line

_____ Ft. from E. Line

330 Ft. from W. Line

SW SW SW
Stanolind DHM

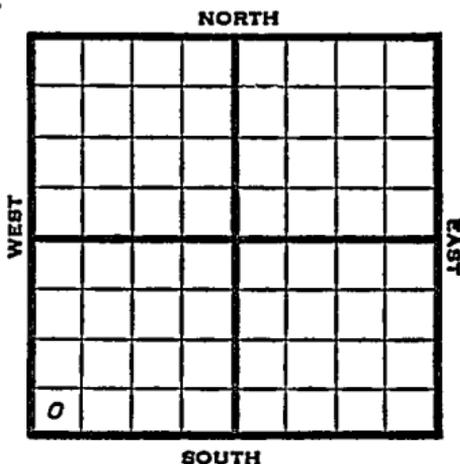

1951

Elev. 1792' REPORT

6/27 Location

7/18 Spud 7-2-51
 D&A TD 3394
 8" @ 263
 Tarkio 2346
 Top. 2675
 DST 2938-76 opn 1/2 hr Rec. 25' so&gcm
 Br Lime 3074 Lans. 3088
 DST 3077-81 opn 1/2 hr
 Rec. 10' mud DST 3102-50 opn 1/2 hr
 Rec. 8' mud Cong. 3362
 TD 3394 D&A

ABANDONED

County _____ State _____

Sec. **Barton** (Twp.) **17** (Sur. Rge.) **19** **Kansas** Map No. **11W**

Operator **Lario Oil**

Well No. **2** Farm **Birzer**

Elev. _____ Location _____

FIRST REPORT		SW	SW	SW
		Ft. From	Line	
		330	Ft. From	S Line SW Quarter
		350	Ist. Report	W JUN 27 1951
		Completion _____		
		Remarks _____		
		Stanolind - IHM		
		Sterling - Contr.		
		Spudding Date _____		






Drlg. Data _____

Hammeke Pool

Location _____

County Barton State Kansas

Sec. 17 (Blk. 19) (Sur. 11W) (Twp. 19) (Rge. 11W) Map No.

Operator Lario Oil

Well No. 2 Farm Birzer

Elev. 1792 Location SW SW SW

0					

330 Ft. From S Line SW

330 Ft. From W Line Quarter

1st. Report

Completion JUL 18 1951

Remarks Hammeke Pool

Sterling Drlg. - Contr.

Spudding Date 7-2-51

Drlg. Data D & A TD 3394

8" @ 263 Tarkio 2346 Top. 2675

DST 2938-76 open $\frac{1}{2}$ hr. Rec. 25' so & gcm

Br. lime 3074- Lans. 3088 DST 3077-81

open $\frac{1}{2}$ hr. Rec. 10' mud DST 3102-50

open $\frac{1}{2}$ hr. Rec. 8' mud Cong. 3362

TD 3394 D & A