FORM 51 25M 3-49 PETROL

Barton

Section 17 Township 19 Range 11W

Well No. #1 Hammeke

Company E. H. Edair et al

NORTH

WEST

EAST

SOUTH

FORM 252-B
10M 9-49 PETROL

Barton KANSAS

Sec. 17 Twp. 19 R. 11W

Well No. #1 Hammeke - Farm

E. H. Adair et al Company

Contractor

Wildcat

330' Ft. from N. Line

Ft. from S. Line

Ft. from E. Line

330' Ft. from W. Line

NW NW NW

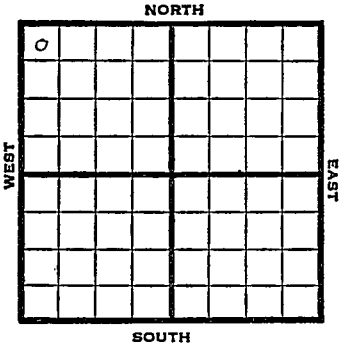

1950	Elev 1773' REPORT
3/15	Spud 3-13-50 8" @ 228' WOC
4/26	TD 3410' 8"@ 228' Anhy 569-600 Topeka 2666' Heebner 2982' Br Lime 3047 Lans 3065' SO 3068-73 3088-96' DST 3068-98' Rec 370' oil Cong 3337' Arb 3368-70 5"@ 3369' 32/3228-26 500 A Swab 6 boph 2500 A Swab 12 boph PB 3180 24/3158-66 FU 1200' oil 2500 A Swab 6 boph PB 3145' 24/3086-94 FU 200' oil 45 mins

OVER

1950

4/26 Information brought forward

24/3062-70
FU 400' oil 1 hr
Swab 6 boph
4000 A
Flow 70 boph 3 hrs.
Flow 43 bo ½ hr
Comp 1553 bopd
Comp

COMPLETED

Form 26 200 Bks. 11-49 Petrol

Kansas

Wildcat

Map No. _____ Sec. 17 Twp. 19 R. 11W

Well No. 1 Hammeke

E. H. Adair etal. Company

Contractor

NW NW NW

330 Ft. from N. Line

Ft. from S. Line

Ft. from E. Line

330 Ft. from W. Location

Barton County

SECTION PLAT

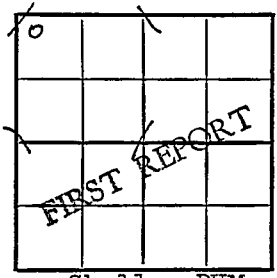

Skelly DHM

Location

Rig up

Drilling and Remarks:

Spud 3-13-50

8" @ 228

WOC

RECORD

Cased _____ in., _____ ft.

Sand

Gas

Oil

Total Depth

PRODUCTION

1st 24 hrs. Nat.

1st 24 hrs. after shot

Gas _____ Cu. Ft.

Dry Hole

Abandoned

Date

MAR 15 1950 19

J. E. TYRA Scout

Scout Cards
Land Small Map
Tr
Pierce Map
Misc.

MAR 17 1950

Form 26 200 Bks. 11-49 Petrol

Kansas Wildcat

Map No. _____ Sec. 17 Twp. 19 R. 11W

Well No. 1 Hammeke

E. H. Adair etal. Company

Contractor

NW NW NW

El. 1773

SECTION PLAT

330 Ft. from N. Line

Ft. from S. Line

Ft. from E. Line

330 Ft. from W. Line

COMPLETE

Barton County

Location

Rig up

Drilling and Remarks:

8" C 228
anhy 569-600
Topeka 2666
Hebner 2982
Br lime 3047
Lana 3065
S.O. 3068-73
" 3088-96

RECORD

Cased _____ in., _____ ft.

Sand

Gas

Oil

Total Depth 3410

PRODUCTION

1st 24 hrs. Nat.

1st 24 hrs. after shot

Gas _____ Cu. Ft.

Dry Hole

Abandoned

Date

APR 26 1950 19

J. E. TYRA Scout

DST 3068-98
Rec. 370' oil
Cong. 3337
Arb. 3368-70
5" C 336
32/ 3228
500 A
Swab 6 bbl
2500 A
Swab 12 bbl
PB 3180
24/ 3158-66
7H. 1200' oil
2500 A
Swab 6 bbl
PB 3145
24/ 3086-94
7H 200' oil 45 min
24/ 3062-70
7H 400' oil 1 hr.
Swab 6 bbl
4000 A
Flow 70 bbl 3 hr.
43 bo ½ hr.
Comp. 1553 bbl

Scout Cards
Land Small Map
Land Wall Map
Tracings
France Map
Pierce Map
Misc.