


Section 17 Township 19 Range 10-W

Well No. #1 Mansz

Company Lion Oil

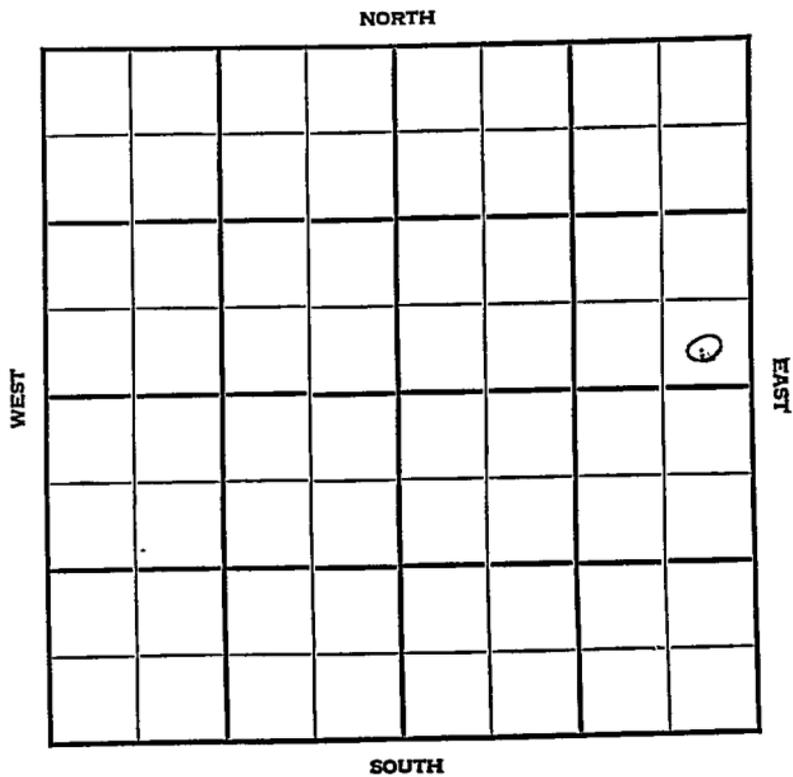

KANSAS

Rice



Sec. 17 Twp. 19 R. 10W

Well No. #1 Mansz Farm

Lion Oil Company

SE NE

NORTH


\_\_\_\_\_ Ft. from N. Line

330' Ft. from S. Line

330' Ft. from E. Line

\_\_\_\_\_ Ft. from W. Line

SE NE

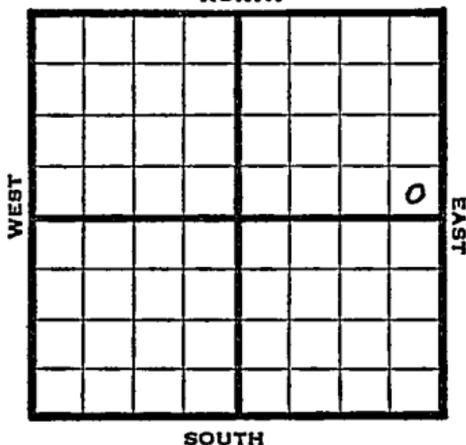

1948

Eli 1767'

REPORT

7/8 RUR  
 7/14 8" @ 210'  
 Drlg 1700'  
 7/21 Drlg 2100'  
 7/28 Lansing 3009'  
 Arb. 3325-28'  
 TD 3328'  
 Run 5"  
 8/4 5" @ 3326'  
 8/11 TD 3344'  
 Swb 3 1/2 bbls oil 2 1/2 hrs  
 8/18 Arb. 3325'  
 5" @ 3326'  
 TD 3344'  
 Pump 30 oil pot  
 41° Gr.  
 Comp

**COMPLETED**

Map No. \_\_\_\_\_ Sec. 17 Twp. 19 R. 10W

Well No. 1 Mansz

Lion Oil Company

FIRST REPORT

Contractor

SE NE

SECTION PLAT

\_\_\_\_\_ Ft. from N. Line

330 Ft. from S. Line

330 Ft. from E. Line

\_\_\_\_\_ Ft. from W. Line


Rice County

Location \_\_\_\_\_

Rig up \_\_\_\_\_

Drilling and Remarks:

R U R

RECORD

Cased \_\_\_\_\_ in., \_\_\_\_\_ ft.

Sand \_\_\_\_\_

Gas \_\_\_\_\_

Oil \_\_\_\_\_

Total Depth \_\_\_\_\_

PRODUCTION

1st 24 hrs. Nat. \_\_\_\_\_

1st 24 hrs. after shot \_\_\_\_\_

Gas \_\_\_\_\_ Cu. Ft.

Dry Hole \_\_\_\_\_

Abandoned \_\_\_\_\_

Date

JUL 8 1948 19

S. J. LEWIS

Scout

Rice County Kansas State

Map No. 46 Sec. 17 Twp. 19 R. 10W

Well No. 1 Mansz

Lion Oil Company

**COMPLETE**

Contractor

SE NE

*E11767*  
SECTION PLAT

\_\_\_\_\_ Ft. from N. Line

330 Ft. from S. Line

330 Ft. from E. Line

\_\_\_\_\_ Ft. from W. Line

									6

Bowman Pool  
Remarks:

*Cor 3325*

*5" Cor 326*

*YTD 3344*

*Pump 30 oil Port*

*41-Gr*

Date

Scout **S. J. LEWIS**

**AUG 18 1948**