

Section 17 Township 19 Range 10WWell No. #1 HagerCompany D. R. Lauck

NORTH

WEST

EAST

0							

SOUTH

Rice KANSAS

Sec. 17 Twp. 19 R. 10W ✓

Well No. #1 Hager Farm

D. R. Lauck Company

D. R. Lauck Contractor

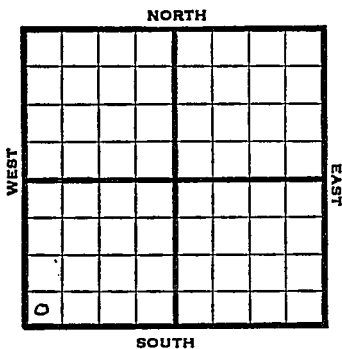
 Ft. from N. Line

330' Ft. from S. Line

 Ft. from E. Line

330' Ft. from W. Line

SW SW SW .



1950

Elev 1779'

REPORT

4/12

Location

5/3

TD 3578'

10"@ 133'

Lans 3038'

Cong 3329'

Arb. 3333'

5"@ 3333'

D&A

Aband.

ABANDONED

Kansas

Map No. _____ Sec. 17 Twp. 19 R. 10WWell No. 1 HagerD. R. Lauck

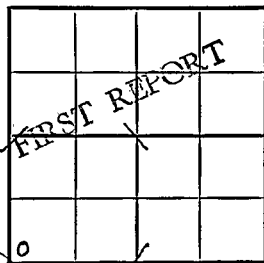
Company

D. R. Lauck

Contractor

SW SW SW

SECTION PLAT

 Ft. from N. Line330 Ft. from S. Line Ft. from E. Line330 Ft. from W. Line

Rice County

Location XRig up

Drilling and Remarks:

RECORD

Cased in., ft.Sand Gas Oil Total Depth

PRODUCTION

1st 24 hrs. Nat. 1st 24 hrs. after shot Gas Cu. Ft.Dry Hole Abandoned

Date

APR 12 195019J. E. TYRA

Scout

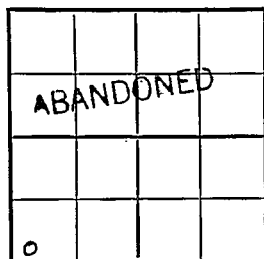
Kansas

Map No. _____ Sec. 17 Twp. 19 R. 10WWell No. 1 Hager

_____ D. R. Lauck _____ Company

_____ Contractor

SW SW SW

E/ 1779
SECTION PLAT

ABANDONED

0

_____ Ft. from N. Line

330 _____ Ft. from S. Line

_____ Ft. from E. Line

330 _____ Ft. from W. Line

Rice County

Location _____

Rig up _____

Drilling and Remarks:

10" @ 133
 Lens 3038
 Cong 3329
 Arb 3333
 5" @ 3333
 DVA

RECORD

Cased _____ in., _____ ft.

Sand _____

Gas _____

Oil _____

Total Depth 3578

PRODUCTION

1st 24 hrs. Nat. _____

1st 24 hrs. after shot _____

Gas _____ Cu. Ft.

Dry Hole _____

Abandoned _____

Date

MAY 3

1950

J. E. TYRA

Scout