

KANSAS


FORM 51 IOM 12-46 PETROL

Rice county

Section 17 Township 19 Range 10-W

Well No. #1, Hager

Company Keyes Drlg.

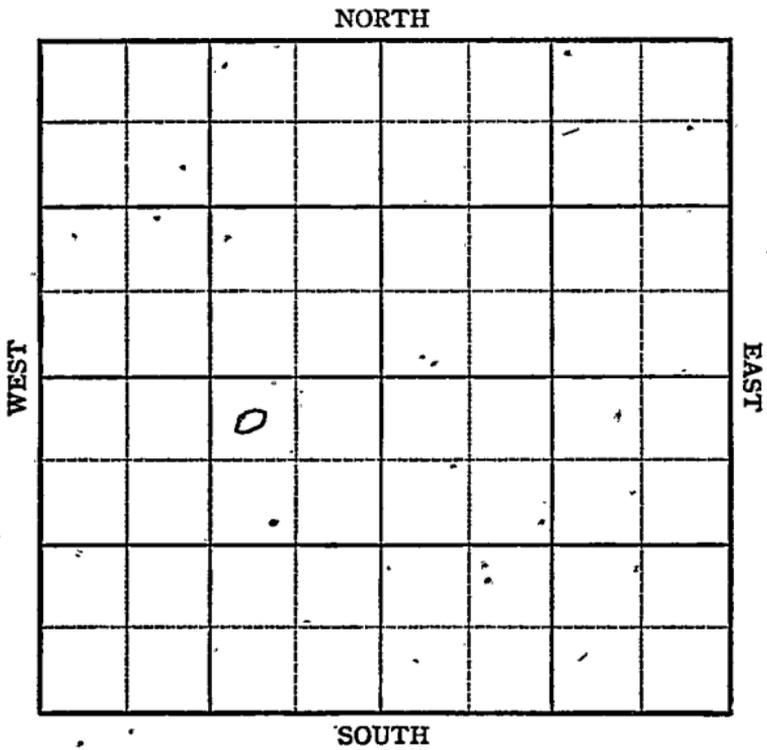

KANSAS

Rice County

Sec. 17 Twp. 19 R. 10-W

Well No. 1 Hager Farm

Keyes Drlg. Company

Silica Pool


330 Ft. from N. Line

Ft. from S. Line

990 Ft. from E. Line

Ft. from W. Line

NW NE SW

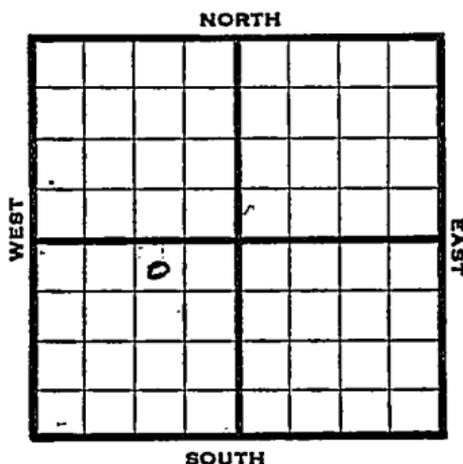

1947

Elev. 1766' REPORT

1/15

8" @ 150'
drlg. 2850'


1/22

Lans 3024'
Arb 3361'
TD 3370'

ABANDONED

Kansas **KANSAS**Map No. 46 Sec. 17 Twp. 19 R. 10WWell No. 1 HagerKeyes Drlg. Company**FIRST REPORT** Contractor

NW NE SW

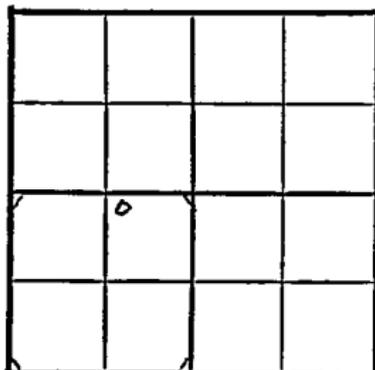SECTION PLAT330 Ft. from N. Line Ft. from S. Line990 Ft. from E. Line Ft. from W. Line

Rice County

Location _____

Rig up _____

Drilling and Remarks:

8" @ 150

drlg. 2850

RECORD

Cased _____ in., _____ ft.

Sand _____

Gas _____

Oil _____

Total Depth _____

PRODUCTION

1st 24 hrs. Nat. _____

1st 24 hrs. after shot _____

Gas _____ Cu. Ft.

Dry Hole _____

Abandoned _____

Date

JAN 15 1947 19

S. J. LEWIS Scout

Map No. 146 Sec. 17 Twp. 19 R. 10W

Well No. 1 Hager

Keyes Drlg. Company

ABANDONED

Contractor

NW NE SW

E 11766

SECTION PLAT

330 Ft. from N. Line

_____ Ft. from S. Line

990 Ft. from E. Line

_____ Ft. from W. Line

	0		

Rice County

Location _____

Rig up _____

Drilling and Remarks:

Home 3024

Or 8361

RECORD

Cased _____ in., _____ ft.

Sand _____

Gas _____

Oil _____

Total Depth 330

PRODUCTION

1st 24 hrs. Nat. _____

1st 24 hrs. after shot _____

Gas _____ Cu. Ft.

Dry Hole _____

Abandoned _____

Date

JAN 22 1947 19

S. J. LEWIS

Scout