

KANSAS


FORM 51 5M BRIX

Rice County

Section 17 Township 19 Range 10W

Well No. #1 Seiverling

Company Lauch & Moncrief

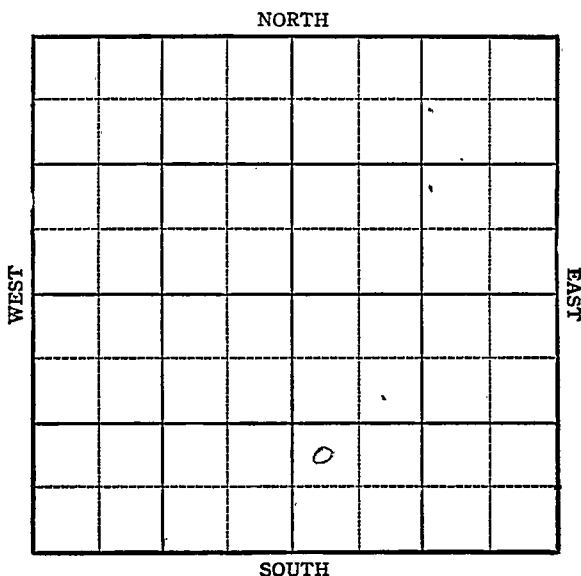

Pice Co.


Ames

Sec. 17 **KANSAS** Twp. 19 R. 10W

Well No. 1 Seiverling Farm
Lauch & Moncrief Company

NW SW SE

NORTH

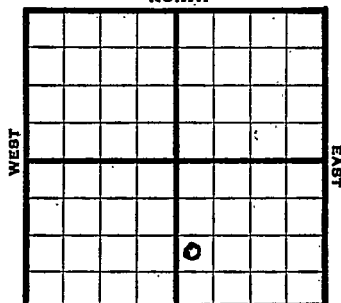

 Ft. from N. Line

990 Ft. from S. Line

 Ft. from E. Line

330 Ft. from W. Line

Elev. 1767

1944

REPORT

9-13 Spud
9/21 10" @ 115
Drlg. 2240
9/28 Lans 3025
Gong. 3313
Arb 3333
Coring 3340
10/4 TD 3348 Sat.
5" @ 3332 RUST
10/11 " " " " "
11/18 Arb 3333
5" @ 3332
TD 3362
Wtr.

ABANDONED

KANSAS


Pool Name Ame SMap No. 46 Sec. 17 Twp. 19 R. 107Well No. I SeiverlingLauch & Moncrief Company

FIRST REPORT

Contractor

NW SW SE

SECTION PLAT

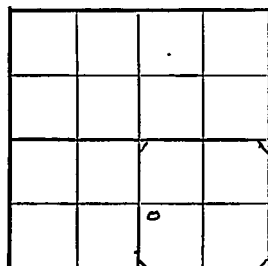 Ft. from N. Line990 Ft. from S. Line Ft. from E. Line330 Ft. from W. Line

Rice County

Location Rig up

Drilling and Remarks:

Spud

RECORD

Cased in., ft.Sand Gas Oil Total Depth

PRODUCTION

1st 24 hrs. Nat. 1st 24 hrs. after shot Gas Cu. Ft.Dry Hole Abandoned

Date

SEP 13 1944 19


S. J. LEWIS Scout

KANSAS Pool Name AmesMap No. 46 Sec. 17 Twp. 19 R. 10WWell No. 1 SeiverlingLauch & Moncrief CompanyABANDONED

Contractor

NW SW SE

SECTION PLAT

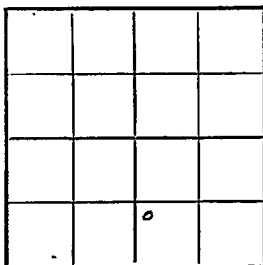 Ft. from N. Line990 Ft. from S. Line Ft. from E. Line330 Ft. from W. LineRice County

RECORD

Location Rig up

Drilling and Remarks:

Ar 833335" @ 3332.WaterCased in., ft.Sand Gas Oil Total Depth 8362

PRODUCTION

1st 24 hrs. Nat. 1st 24 hrs. after shot Gas Cu. Ft.Dry Hole Abandoned

Date

OCT 18 1944

19

S. I. LEWIS

Scout