


Section 17 Township 19 Range 11 W

Well No. #1-B Hiss

Company Leben Oil

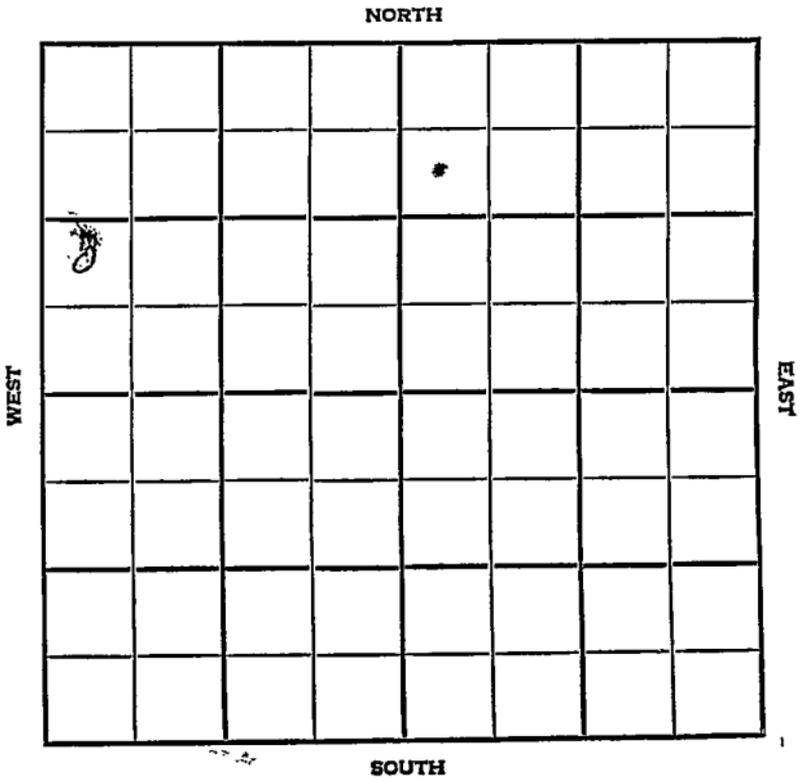

Barton

Kansas

SEC.	TWP.	R.
17	19	14W

WELL NO. #1-B Hiss FARM

COMPANY Lebon Oil

CONTRACTOR


W. Heizer

\_\_\_\_\_ Ft. from N. Line

\_\_\_\_\_ Ft. from S. Line

\_\_\_\_\_ Ft. from E. Line

\_\_\_\_\_ Ft. from W. Line

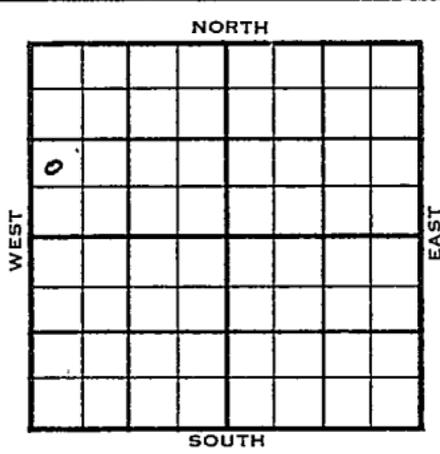

NW SW NW

1955	ELEVATION 1907	REPORT
------	-------------------	--------

8/3

Comm 5-9-55

Anh 852

H 3137

Tr 3158

BL 3221

L 3234 3232

BKC 3415

C 3477

A 3546 3546

TD 3551 3552

8" @ 566 lost surface pipe skid rig 50' north DST 3302-08

open 1 hr. Rec 310' sw 1320#

DST 3388-97 open 1 1/2 hr. Rec 70'

o & gem 660/20" DST 3547-51

open 1 hr Rec 2100' gip 840' oil

880# 5 1/2" @ 3547 CO to 3551

850' oil in hole S/75 bo 11 hr.

Comp 225 bopd

**FIRST REPORT**

*+*

**COMPLETED**

County Barton Elev. 1907  
 Sec. 17 Twp. 19 Rge. 11W  
 Company Leben Oil  
 Farm Name Hiss No. 1-B

TOPS	DEPTH	LOG	DATUM
Anh.	852		
Tr.		3137	1230
Dg.		3158	1251
Bl.		3221	1314
L.	3234	3232	1325
K.C.		3415	1508
B.K.C.		3477	1570
Ce.			
C.			
M.			
M.			
K.			
Mz.			
Me.			
V.			
S.			
S.			
A.	3546	3546	1639
R.			
Pe.			
G.			
T.D.	3551	3552	

Loc. in Sec. NW SW NW

Geol. \_\_\_\_\_

Contr. \_\_\_\_\_

Pool W. Heizer

**FIRST REPORT**  
**COMPLETE**

Date Comm. 5-9-55 . AUG 3 1955

8" @ 566 lost surface pipe  
skid rig 50' north DST 3302-08  
open 1 hr. Rec. 310' sw 1320#  
DST 3388-97 open 1 1/2 hr. Rec. 70'  
o & g cm 660/20" DST 3547-51  
open 1 hr. Rec. 2100' gip 840' oil  
880# 5 1/2" @ 3547 CO to 3551 850' oil  
in hole S/ 75 bo 11 hr.  
Comp. 225 bopd