


Section 17 Township 19 Range 11 W

Well No. #2 Hiss

Company Leben Brlg.

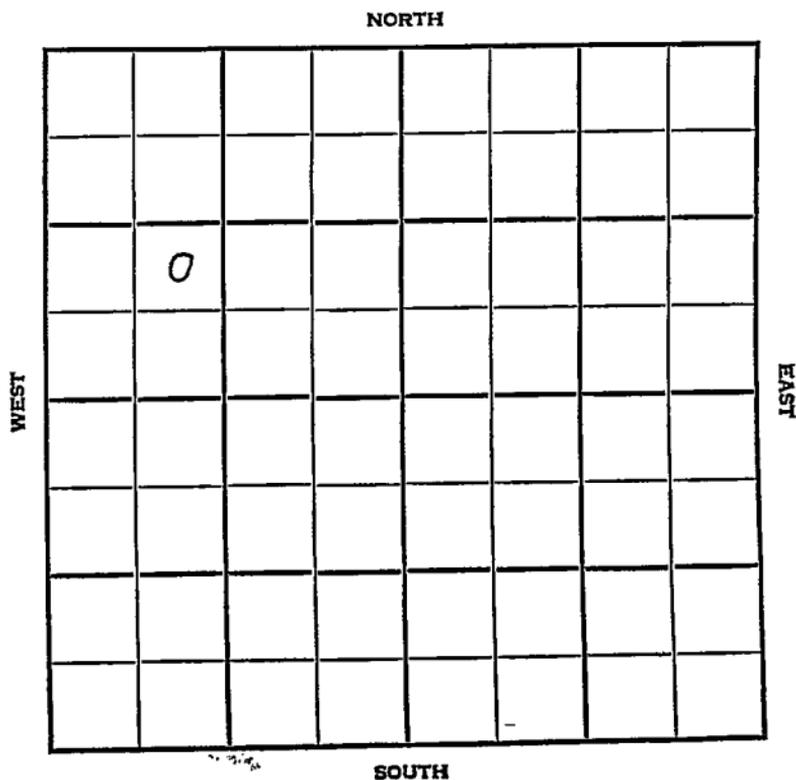

Barton

KANSAS

SEC.	TWP.	R.
17	19	11W

WELL NO.

#2 Hiss
COMPANY

FARM

Leben Drlg.

CONTRACTOR

Co. Tools

W. Heiser


_____ Ft. from N. Line

_____ Ft. from S. Line

_____ Ft. from E. Line

_____ Ft. from W. Line

NE SW NW

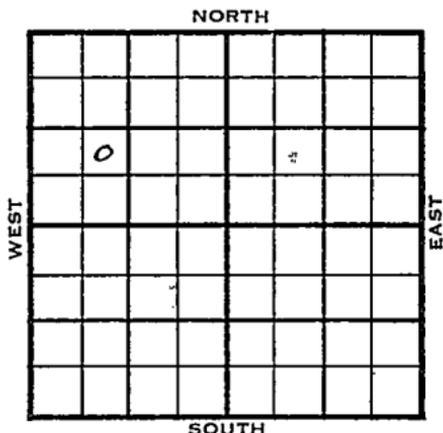

1955	ELEVATION	REPORT
	1909 RB 1907 DF	

7/20 Comm 7-14-55
8" @ 912/425
Drlg. 2712

10/5 Comm 7-14-55
8" @ 912/425
Anh 1789
H 3140
L 3235
A 3540
TD 3544 1/2

DST 3237-50 open 1 hr gas to surface
in 49 min. Rec ~~25~~ 45' hg & mco
195' free oil 680/20" DST 3541-
44 gas to surface in 4 min. open 1 hr
Rec 1105' oil 970/30" 5 1/2" @
3540 CO to 3544. FU 1500' oil 1 hr
P/20 bo 90% wtr 16/3540-41 8/3543-
44 DD 3545 S/28 BO 24 bwpd
Comp 25 bopd ~~15~~ 15 bw

COMPLETED

County Barton Elev. _____
 Sec. 17 Twp. 19 Rgs. 14W
 Company Leben Drlg.
 FarmName Hiss No. 2

Co.
Lse.
No.
Sec.
T.
R.

TOPS	DEPTH	LOG	DATUM
Anh.			
Tp.			
H.			
Tr.			
Dg.			
Bl.			
L.			
K.C.			
B.K.C.			
Ce.			
C.			
M.			
M.			
K.			
Mz.			
Ma.			
V.			
S.			
S.			
A.			
R.			
PE.			
G.			
T.D.			

Loc. in Sec. NE SW NW
 Geol. _____
 Contr. _____
 Co. tools _____
 Pool _____
W. Heiser

JUL 20 1955
FIRST REPORT

Date Comm. 7-14-55
8" @ 912/425 drlg. 2712

[Handwritten signature]

County Barton Elev. 1907 DF
1909 RB
 Sec. 17 Twp. 19 Rge. 11W
 Company Leben Drlg.
 Farm Name Hiss No. 2

TOPS	DEPTH	LOG	DATUM	Loc. in Sec.
Anh.	1789			NE SW NW
TP.				
H.	3140		1231	
Tr.				
Dg.				
Bl.				
L.	3235		1326	Geol.
K.C.				Contr.
B.K.C.				Co. tools
Ce.				Pool
C.				W. Heizer
M.				
M.				
K.				
Mz.				
Me.				
V.				
S.				
S.				
A.	3540		1631	
R.				
PE.				
G.				
TD.	3544 1/2			

COMPLETE

Date Comm. 7-11-55 OCT 5 1955
 8" @ 912/125 DST 3237-50 open 1 hr.
 gas to surface in 49 min. Rec. 15' hg &
 mco 195' free oil 680/20" DST 3511-
 1/4 gas to surface in 4 min. open 1 hr.
 Rec. 1105' oil 970/30" 5 1/2" @ 3540
 CO to 351/4 FU 1500' oil 1 hr.
 P/ 20 bo 90% wtr. 16/ 3510-1/4
 8/ 3513-1/4 DD 3545 S/ 28 bo 24 bwpd
 Comp. 25 bopd 15 bw