

Barton **KANSAS**Section 17 Township 19 Range 11WWell No. 1 MertenCompany Lee Phillips

NORTH

0							

WEST

EAST

SOUTH

Barton

KANSAS

SEC.	TWP.	R.
17	19	14W

WELL NO.

#1 Merten

FARM

COMPANY

Lee Phillips

CONTRACTOR

Mast. Drlg.


_____ Ft. from N. Line

_____ Ft. from S. Line

_____ Ft. from E. Line

_____ Ft. from W. Line

SW NW NW

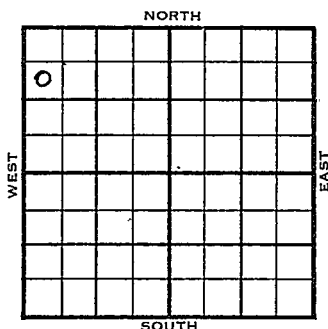

1955	ELEVATION	REPORT
	19096	

7/6

Comm. 6-28-55

8" @ 865/425 Drlg. 2780

8/10

Comm 6-28-55

H 3144

BL 3229

L 3249

A 3532

TD 3541

8" @ 865/425 DST 3397-3403 open 1/2

hr. Rec 30' mud Off DST 3537-41 open

1 hr Rec 510' gas 570' oil

530/20" 5 1/2" @ 3537 GO to 3541

S/8 1/2 boph P/25 bopd

Comp 202 bopd

COMPLETED

County Barton Elev. _____
Sec. 17 Twp. 19 Rgs. 14W
Company Lee Phillips
Farm Name Merten No. 1

TOPS	DEPTH	LOG	DATUM
Anh.			
Tp.			
H.			
Tr.			
Dg.			
BL.			
L.			
K.C.			
B.K.C.			
Ce.			
C.			
M.			
M.			
K.			
Mz.			
Ma.			
V.			
S.			
S.			
A			
R.			
Pe.			
G.			
T.D.			

Loc. in Sec. SW NW NW

Geol. _____

Contr. Mast Drlg.

Pool W. Heizer

FIRST REPORT			
JUL		6 '55	

Date Comm. 6-28-55
8" @ 865/425 drlg. 2780

[Handwritten signature]

County Barton Elev. 1909
 Sec. 17 Twp. 19 Rge. 11W
 Company Lee Phillips
 Farm Name Merten No. 1

TOPS	DEPTH	LOG	DATUM
Anh.			
Tr.			
H.	<u>3144</u>		<u>1235</u>
Tr.			
Dg.			
BL.	<u>3229</u>		<u>1320</u>
L.	<u>3249</u>		<u>1332</u>
K.C.			
B.K.C.			
Ce.			
C.			
M.			
M.			
K.			
Mz.			
Mq.			
V.			
S.			
S.			
A	<u>3532</u>		<u>1123</u>
R.			
PE			
G.			
T.D.	<u>3541</u>		

Loc. in Sec. SW NW NW


Geol. _____

Contr. _____

Mast Drlg. _____

Pool _____

W. Heizer

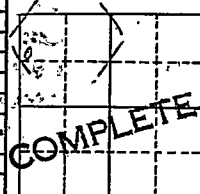

Date Comm. 6-28-55 AUG 10 1955
8" @ 865/425 DST 3397-3403 open $\frac{1}{2}$ hr.
Rec. 30' mud O# DST 3537-41 open
1 hr. Rec. 510' gas 570' oil 530/201
 $5\frac{1}{2}$ " @ 3537 GO to 3541 S/ $8\frac{1}{2}$ boph
P/ 25 bopd ad Comp. 202 bopd