


Section 17 Township 19 Range 11 W

Well No. #1 Hiss

Company Leben Oil

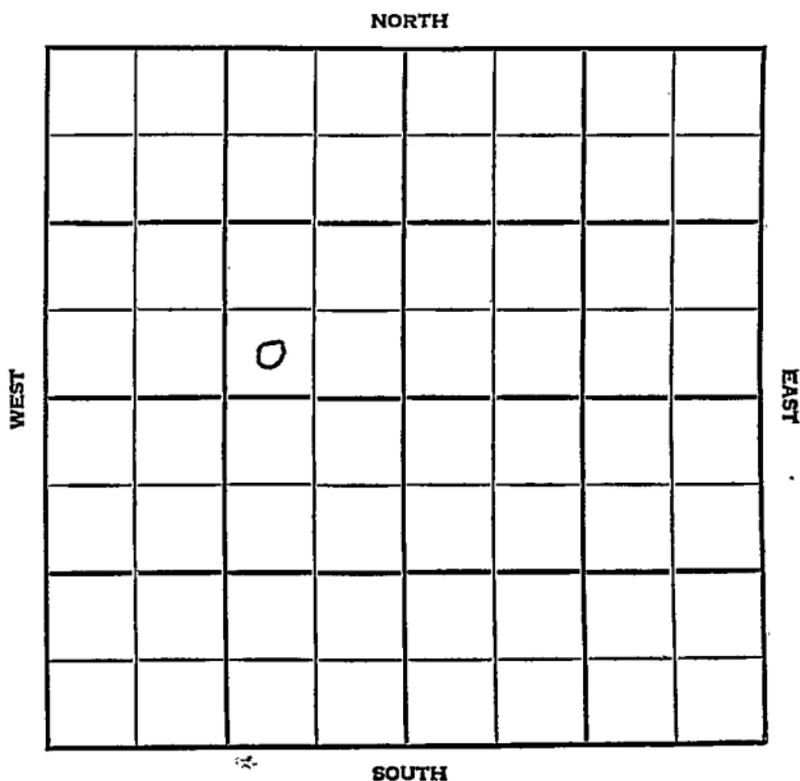

Barton**KANSAS**

SEC. 17	TWP. 19	R. 14W
------------	------------	-----------

WELL NO.

#4 Hiss

FARM

COMPANY

Leben Oil

CONTRACTOR

Co. Tools

W. Heizer


_____ Ft. from N. Line

_____ Ft. from S. Line

_____ Ft. from E. Line

_____ Ft. from W. Line

SW SE NW

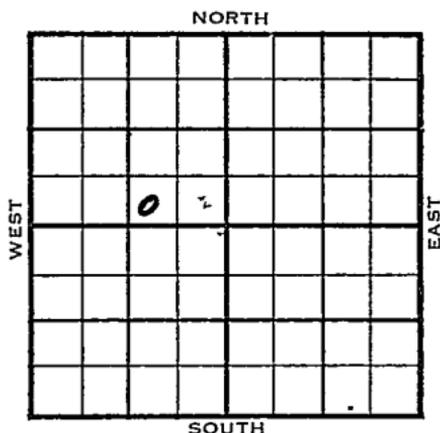

1955

ELEVATION

1905'

REPORT

FIRST REPORT

8/10

Comm: 8/7/55

8" @ 854/400 WOC

10/19

Comm 8-7-55

8" @ 854/400

Anh 855

Ft. Riley 1794

H 3143

Tr 3162

Dg 3176

Bl 3227

L 3238

C 3489

A 3535

TD 3543

DST 3238-47 open 1 hr Rec 420' gas

60' ho & GCM 1100/30" DST

3376-3410 open 1 hr rec 30' socm

0/30" 5 1/2" @ 3536 60 to 3543

FU 800' oil 1 hr P/2 1/2 hp 5 d₂ys

Comp 86 bopd

COMPLETED

County Barton Elev. _____
 Sec. 17 Twp. 19 Rge. 11W
 Company Leben Oil
 FarmName Hiss No. 4

TOPS	DEPTH	LOG	DATUM
Anb.			
Tp.			
H.			
Tr.			
Dg.			
Bl.			
L.			
K.C.			
B.K.C.			
Ce.			
C.			
M.			
M.			
K.			
Mz.			
Mq.			
V.			
S.			
S.			
A.			
R.			
PE.			
G.			
T.D.			

Loc. in Sec. _____
SW SE NW
 Geol. _____
 Contr. _____
Co. tools
 Pool _____
W. Heizer

AUG 10 '55
 e.
FIRST REPORT

Date Comm. 8-7-55
8" @ 854/400 WOC

[Handwritten signature]

Co.
Lse.
No.
Sec.
T.
R.

County Barton Elev. 1905
 Sec. 17 Twp. 19 Rge. 14W
 Company Leben Oil
 Farm Name Hiss No. 4

TOPS	DEPTH	LOG	DATUM
Anh.	1855		
Tp. <u>ft Riley</u>	11794		
H.	13143		1238
Tr.	3162		1257
Dg.	3176		1271
BL.	3227		1322
L.	3238		1333
K.C.			
B.K.C.			
Ce.			
C.	3489		1584
M.			
M.			
K.			
Mz.			
Me.			
V.			
S.			
S.			
A	3535		1630
R.			
PE.			
G.			
T.D.	3543		

Loc. in Sec. SW SE NW
 Geol. _____
 Contr. _____
 Co. tools _____
 Pool _____
W. Heizer

 COMPLETE

Date Comm. 8-7-55 OCT 19 1955

8" @ 854/400 DST 3238-47 open 1 hr
 Rec. 420' gas 60' ho & gcm 1100/30"
 DST 3376-3410 open 1 hr. rec. 30'
 socm 0/30" 5 1/2" @ 3536 CO to 3543
 FU 800' oil 1 hr. P/ 2 1/2 bo 5 days
 Comp. 86 bopd

Co.
Lse.
No.
Sec.
T.
R.