

Map No. KANSAS Sec. 17 Twp. 19 R. 17 W


Well No. 1- Pivonka Farm

Danceger et al Company

NORTH

WEST

EAST

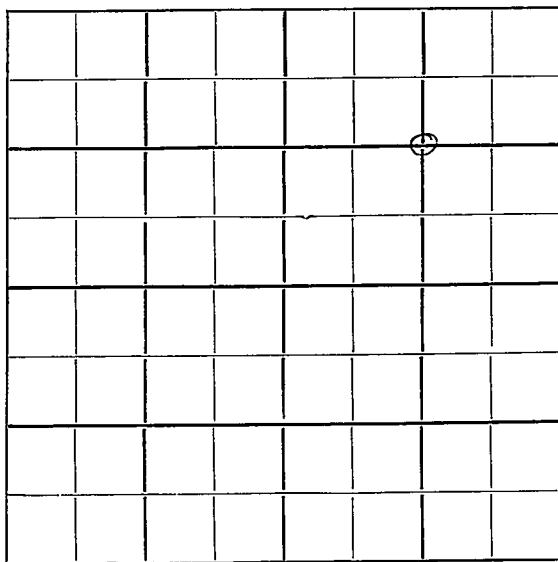

SOUTH

Location.....

Drilling Remarks

.....

.....

RECORD

Cased..... in..... ft.

Sand.....

Gas.....

Oil.....

Total Depth.....

Rig Up.....

Drilling Remarks

.....

.....

PRODUCTION

1st 24 hrs. Nat.....

1st 24 hrs. after shot.....

Gas..... cu. ft.....

Dry Hole.....

Abandoned.....


Map No. **KANSAS** Sec. *17* Twp. *19* R. *17^W*
 Well No. *1 - Pwonka* Farm
Wancey et al Company

1320 Ft. from N. Line

_____ Ft. from S. Line

1320 Ft. from E. Line

_____ Ft. from W. Line

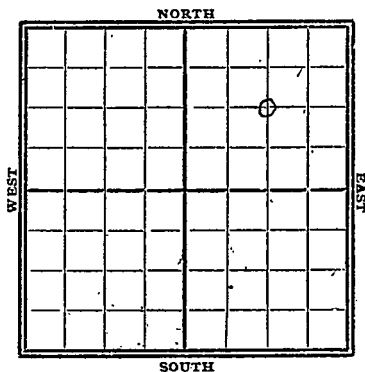

1928

Date	REPORT
<i>11/28</i>	<i>RoG.</i>
<i>12/15</i>	<i>Rig</i>
<i>12/12</i>	<i>Spud & S.D.</i>
<i>12/19</i>	
<i>12/26</i>	
<i>1929</i>	
<i>1/2</i>	<i>Spud 155'</i>
<i>1/9</i>	<i>" 275'</i>
<i>1/16</i>	<i>" 310'</i>
<i>1/23</i>	<i>" 360'</i>
<i>1/30</i>	<i>Orly 450'</i>
<i>2/6</i>	<i>" 535'</i>
<i>2/13</i>	<i>" 570'</i>
<i>2/20</i>	<i>" 580'</i>
<i>2/27</i>	<i>" 775'</i>
<i>3/6</i>	<i>" 900'</i>
<i>3/13</i>	<i>" 1010'</i>
<i>3/20</i>	<i>" 1150'</i>
<i>3/27</i>	<i>no report</i>
<i>4/3</i>	<i>Orly 1600'</i>
<i>4/10</i>	<i>" 2065'</i>
<i>4/17</i>	<i>" 2246'</i>

4/24 - Wrlg 2595'
5/1 - " 2710'
5/8 - W.R. 8" - 2710'
5/14 - Wrlg 2885'
5/22 - " 2965'
5/29 - " 3274
6/2 - " 3420
6/12 - Running 5" - 3448
6/19 - Wrlg 3515
6/26 - faq pipe 3540
7/2 - ---
7/10 - V/R 6" - 3540'
7/17 - Wrlg 3575'
7/24 - " 3677'
7/31 - " 3680
8/7 - " 3740'
8/14 - " 3765'
8/21 - " 3840
8/28 - faq tool 3840
9/4 - ---
9/11 - ---
9/18 - Wrlg 3895
9/25 - St. Ram 6" - 3905
10/2 - ---
10/9 - S.D. 3937' show oil.
10/16 - S.D. 3937
10/23 - Wrlg 3985' - 5" - 3914
10/30 - S.D. 4044'
11/6 - ---
11/13 - ---
11/20 - W.R. 5" - 4130
11/27 - S.D. 4130
12/4 - ---
12/11 - HFW 4135 - 45' - faq tool
12/18 - ---
12/23 - T.D. 4148' in Granite

(Abandoned)

Acacia
Noticing
 MAP NO. KANSAS SEC. 17 TWP. 19 R. 17W

WELL NO. 1 Pivonka

Danciger & Co. COMPANY

CONTRACTOR

SECTION PLAT

		3	

1320 FT. FROM N. LINE

FT. FROM S. LINE

1320 FT. FROM E. LINE

FT. FROM W. LINE

FIRST REPORTS

LOCATION _____

RIG UP _____

DRILLING AND REMARKS:

ROG

RECORD

CASED _____ IN. _____ FT.

SAND _____

GAS _____

OIL _____

TOTAL DEPTH _____

PRODUCTION

1ST 24 HRS. NAT. _____

1ST 24 HRS. AFTER SHOT _____

GAS _____ CU. FT.

DRY HOLE _____

ABANDONED _____

DATE

NOV 28 1928 192 S. J. LEWIS SCOUT

Map No. KANSAS Sec. 17 Twp. 19 R. 12W

Well No. 1 Pampa

Hanciger & Co. Company

Contractor


SECTION PLAT

1320 Ft. from N. Line

..... Ft. from S. Line

1320 Ft. from E. Line

..... Ft. from W. Line

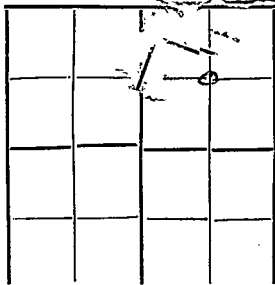

ABANDONED

Location.....

Rig up.....

Drilling and Remarks:

2 7/8 in Granite

RECORD

Cased.....in.,ft.

Sand.....

Gas.....

Oil.....

Total Depth 4148

PRODUCTION

1st 24 hrs. Nat.....

1st 24 hrs. after shot.....

Gas.....Cu. Ft.

Dry Hole.....

Abandoned.....

Date

DEC 23 1929

192

S. J. LEWIS Scout