


Section 17 Township 19 Range 17W

Well No. 1 Schroter

Company W. J. Goppinger

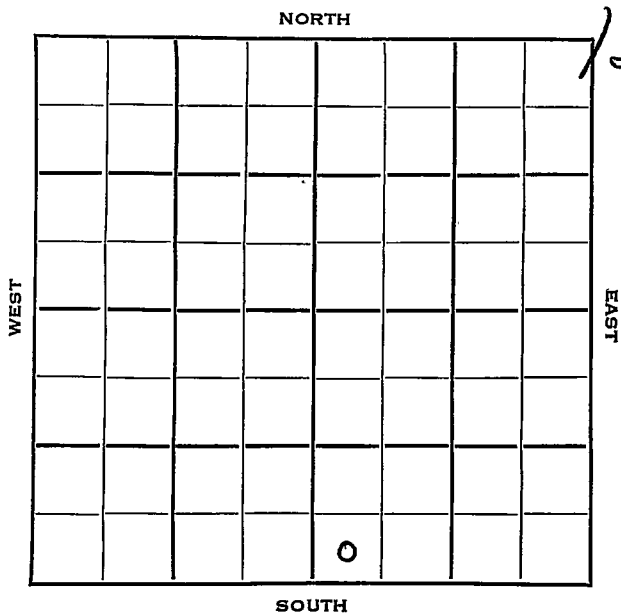

Rush

KANSAS

| | | |
|------|------|-----|
| SEC. | TWP. | R. |
| 17 | 19 | 17W |

WELL NO.

1 Schroter

FARM

COMPANY

W. J. Coppinger

CONTRACTOR


1-

_____ Ft. from N. Line

330 _____ Ft. from S. Line

_____ Ft. from E. Line

330 _____ Ft. from W. Line

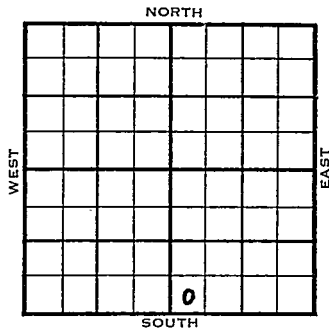

SW SW SE

Aurora Gas - Int.

| | ELEVATION | REPORT |
|------|-----------|--------|
| 1953 | 2155' | |

9/16 Location

9/23. 13" @ 112'

9/30 Drlg. 2900'

10/7 Heeb 3492, Lans 3544, Cong 3866, Ero Arb 3914, Arb 3924

DST 3924'-29' 1 hr, 1 SOCM

DST 3929'-39' 1 h, 8' socm, 40#.

DST 3939'-49' 1 hr, 10' M 440#

10/14

Spud 9-21-53 D & A TD 4009'

13" @ 112 Heeb 3492 Lans 3544

Cong 3866 EroArb. 3914 Arb. 3924

DST 3924-29 open 1 hr rec 1' SOCM

DST 3929-39 open 1 hr rec 8' SOCM

40#

DST 3939-49 open 1 hr rec 10' mud

440# TD 4009' D & A

ABANDONED

