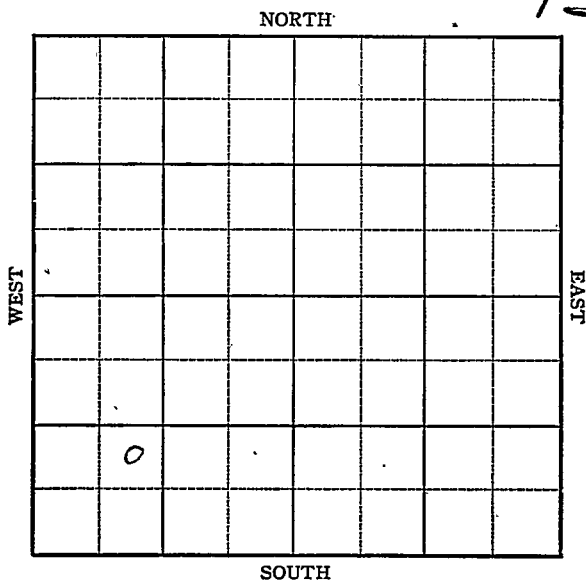


KANSAS

Rush county

Section 17 Township 19 Range 16-WWell No. #1, GreenwaltCompany Alkay Oil

KANSAS

Rush ✓

Sec. 17 Twp. 19 R. 16W

Well No. #1 Greenwalt Farm

Alkay Oil Company
Greenwalt


Ft. from N. Line

990 Ft. from S. Line

Ft. from E. Line

990 Ft. from W. Line

NORTH

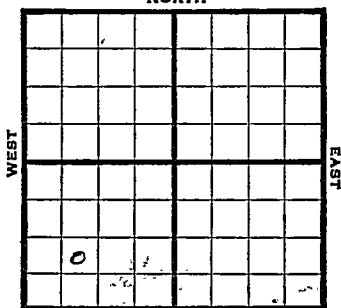

SOUTH

NE SW SW

1946	REPORT
	Elev 2095'
10/9	Location
10/15	"
10/22	RUR
10/29	Drlg 721'
11/6	Anhy 1166'
	8" @ 1178
	Drlg 2620'
11/12	Drlg 3585'
11/20	Lans 3488'
	Arb 3825-45 TD
	5" @ 3825', wtr.
11/27	Arb 3825'
	5" @ 3825'
	TD 3845'
	ABANDONED

KANSAS

Kansas

Greenwalt

Map No. 8 Sec. 17 Twp. 19 R. 16WWell No. 1 GreenwaltAlkay Oil


Company

FIRST REPORT

Contractor

NE SW SW

SECTION PLAT

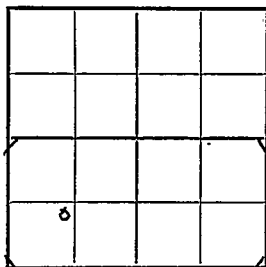 Ft. from N. Line990 Ft. from S. Line Ft. from E. Line990 Ft. from W. LineRush CountyLocation XRig up

Drilling and Remarks:

RECORD

Cased in., ft.Sand Gas Oil Total Depth

PRODUCTION

1st 24 hrs. Nat. 1st 24 hrs. after shot Gas Cu. Ft.Dry Hole Abandoned

Date

OCT 9 1946 19S. J. LEWIS

Scout

Kansas

Map No. 81 Sec. 17 Twp. 19 R. 16WWell No. 1 GreenwaltAlkay Oil Company

ABANDONED

Contractor

NE SW SW

E. 12095
SECTION PLAT Ft. from N. Line990 Ft. from S. Line Ft. from E. Line990 Ft. from W. Line

0			

Rush County

Location Rig up

Drilling and Remarks:

CR 8825
5" @ 8825

RECORD

Cased in., ft.Sand Gas Oil Total Depth 8845

PRODUCTION

1st 24 hrs. Nat. 1st 24 hrs. after shot Gas Cu. Ft.Dry Hole Abandoned

Date

NOV 27 1946 19

S. J. LEWIS

Scout