


Section 18 Township 19 Range 11 W

Well No. # 3 Robl

Company E. H. Adair

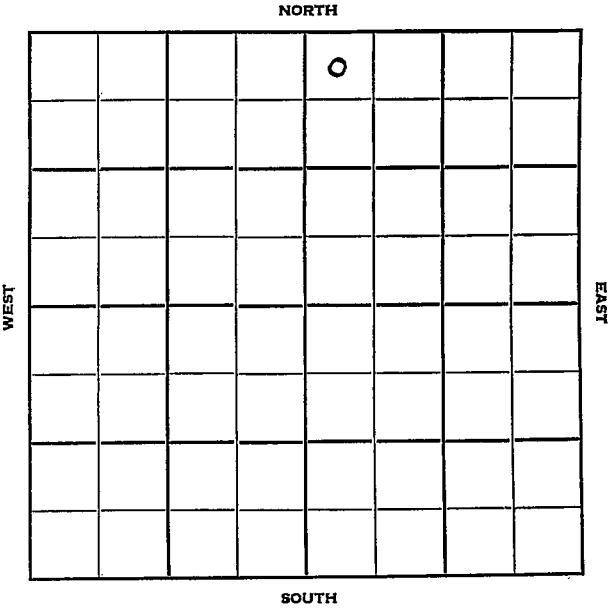

Barton

KANSAS

Sec. 18 Twp. 19 R. 11W ✓

Well No. #3 Robl Farm

E. H. Adair Company

Hammeke Pool Contractor


330' Ft. from N. Line

_____ Ft. from S. Line

_____ Ft. from E. Line

330' Ft. from W. Line

NW NW NE

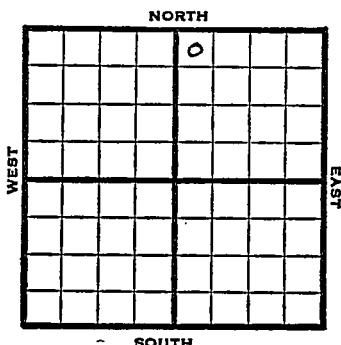

1951 Elev. 1779' REPORT

3/7 Spud 2-28-51
8" @ 236
Anhy 550-80
Drlg. 2682

3/14 Spud 2-28-51 D&A
TD 3382' 5" @ 236
Anhy 550-80 Top. 2675
Heeb. 2935' Br Lime 3051
Lans. 3065' Cong. 3338
Arb. 3366
DST 3364 TD 3382
opn 40 min Rec. 11'mud 930#
D&A

ABANDONED


County Barton State KanSec. 18 (Blk. Twp.) 19 (Sur. Rge.) 11W Map No.Operator E. H. AdairWell No. 3 Farm RoblElev. 1779 Location NW NW NE

330 Ft. From N Line NE330 Ft. From W Line Quarter1st. Report MAR 7 1951

Completion

Remarks Derby DHMSpudding Date 2-28-51Drlg. Data Hammeke Pool8" @ 236 Anhy 550-80 drlg. 2682

J. E. TYRA

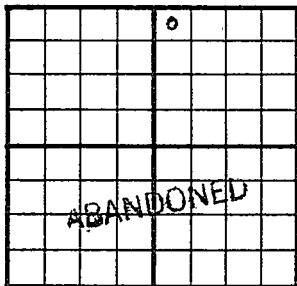County Barton State KansasSec. 18 (Blk.
Twp.) 19 (Sur.
Rge.) 11W Map No.Operator E. H. AdairWell No. 3 Farm RoblElev. 1779 Location NW NW NE330 Ft. From N Line NE330 Ft. From W Line Quarter1st. ReportCompletion MAR 1 4 1951Remarks Hammeke PoolSpudding Date 2-28-51Drlg. Data D & A TD 33828" @ 236 Anhy 550-80 Top. 2675Heeb. 2935 Br. lime 3051 Lans. 3065Cong. 3338 Arb. 3366 DST 3364-82 TDopen 40 min. Rec. 11' mud 930#D & A

J. E. TYRA