


Section 18 Township 19 Range 11 W

Well No. # 1 Robl (B)

Company E. H. Adair

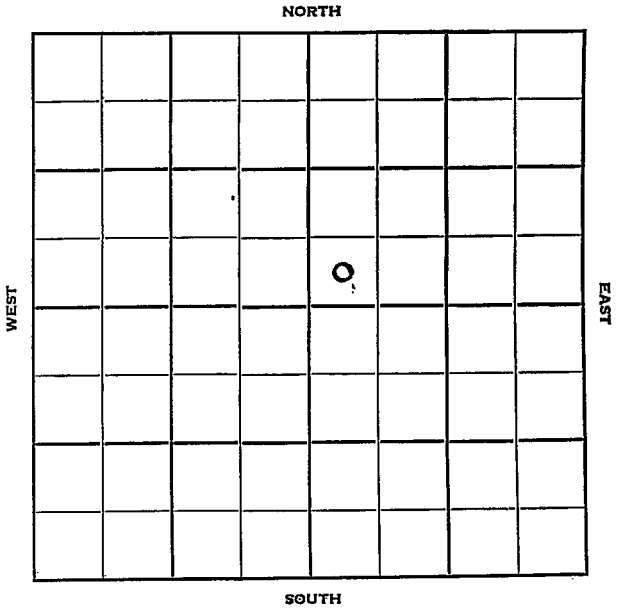

Barton KANSAS

Sec. 18 Twp. 19 R. 11 W

Well No. # 1 Robl (B) Farm

E. H. Adair Company

Adair Contractor


Ft. from N. Line

330 Ft. from S. Line

Ft. from E. Line

330 Ft. from W. Line

NORTH

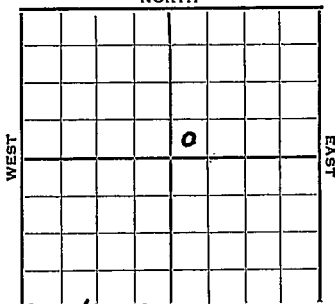

SW SW NE

Derby \$2500 - Stano. FC 5/2 NE SOUTH

1952 Elev. 1796' REPORT

4/9 Spud 4-5-52
8" @ 258'
Anhy 605'

4/16 Spud 4-5-52
D&A TD 3421
8" @ 258
Anhy 605 Top. 2695
Heeb. 2957 Lans. 3092
DST 3093-3123 open 1 hr. rec. 120'
SO&GCM Arb. 3386
DST 3389-96 open 55 min. rec. 15' mud
TD 3421' D&A

ABANDONED

County Barton State Kansas

Sec. 18 (Blk. Twp.) 19 (Sur. Rge.) 11W Map No.

Operator E. H. Adair

Well No. 1 Farm Robl "B"

Elev. 1796 Location SW SWNE

| | | | | | |
|--|--|--|---|--|--|
| | | | | | |
| | | | | | |
| | | | | | |
| | | | 0 | | |
| | | | | | |
| | | | | | |
| | | | | | |
| | | | | | |

ABANDONED

330 Ft. From S Line NE

330 Ft. From W Line Quarter

1st. Report

Completion APR 16 1952

Remarks

Adair - Contr.

Spudding Date 4-5-52

Drlg. Data D & A TD 3421

8" @ 258 Anhy 605 Top. 2695

Heeb. 2957 Lans. 3092 DST 3093-3123

open 1 hr. Rec. 120' so & gcm

Arb. 3386 DST 3389-96 open 55 min.

Rec. 15' mud TD 3421

D & A