

Sec. 18 Twp. 19 R. 12W

Well No. #2 McIlrath Farm

Sunray Company

Stiekel Contractor


Ft. from N. Line

330 Ft. from S. Line

990 Ft. from E. Line

Ft. from W. Line

SW SE SW

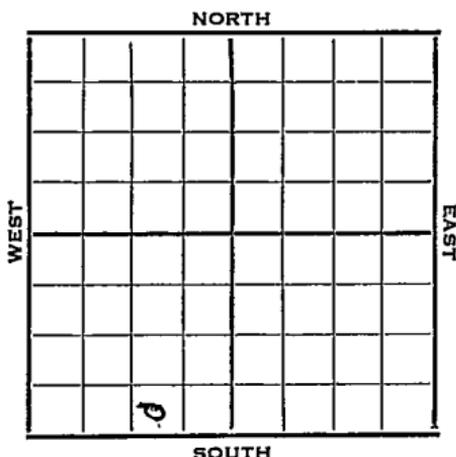

1952 Elev. 1828' REPORT

8/27 Spud 8-25-52
8" @ 221'

9/3 Lans. 3145
DST 3211-17

9/10 DST 3205-17, 40 mins, 120' HO & GCM
90' free oil 386# RTD 3217'
5" @ 3215' CO 3217' 24 gal OPH
2750 A 190 BO 12 hrs.

9/17 F 70 Bopd

9/24 Spud 8-25-52
Oil Well TD 3217' 8" @ 221
Heeb. 3022 Br Li 3131
Lans. 3145
DST 3205-17 open 40 min. rec. 120'
HO&GCM 90' free oil 386#
TD 3217 5" @ 3215 CO to 3217
24 goph 2750A 190 bo 1 2 hr.
F/ 70 bopd Comp. 123 bopd

COMPLETED

