


Barton

Section 18 Township 19 Range 12W

Well No. #5 McIlrath

Company Sunray Oil Company

NORTH

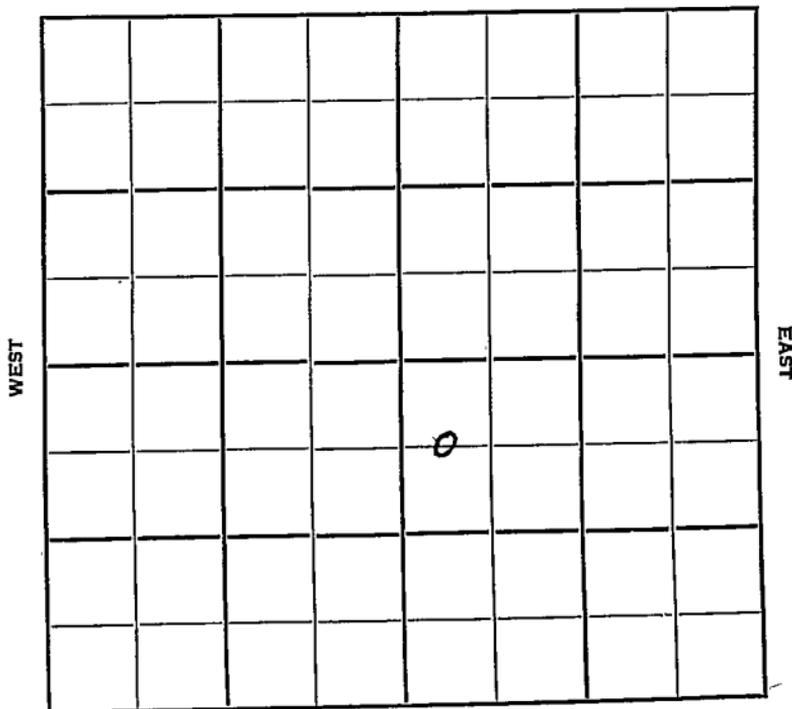

SOUTH

Barton **KANSAS** ✓  
19 R. 12W

Sec. 18 Twp. 19 R. 12W

Well No. #5 McIllrath Farm

Sunray Oil Company

Mouser Drlg. Contractor


660 Ft. from N. Line

Ft. from S. Line

Ft. from E. Line

330 Ft. from W. Line

C W L NW SE

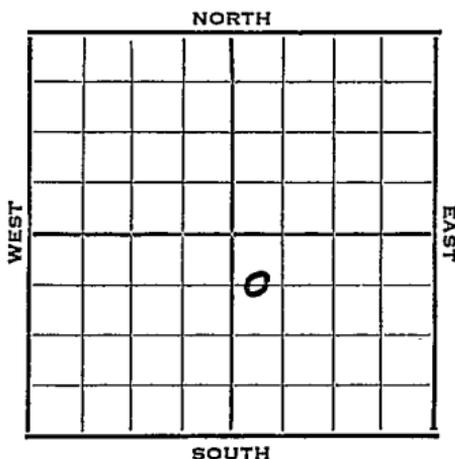

1953 Elev. 1892' REPORT

- 3/18 Spud 3-12-53  
8" @ 251  
Drlg. 2665'
- 3/26 Heeb 3087, Br Li 3200, L ans  
3213  
DST 3242-61, 1 hr., 30' O&GCM  
DST 3270-83 RTD, 1 hr., 45'  
SO&GCM, 130#  
5" @ 3270
- 4/2 CO 3283 SO & W 2500 A  
S/2 1/4 BOPH plus show water.  
PB 2365 24/3253-59 2500 A  
2 BOPH CO 3283 POP
- 4/9 "
- 4/16 NR
- 4/23 "
- 4/30 "
- 5/7 "

OVER

#5 McIlrath

1953

5/20

Spud 3-12-53

Oil Well

TD 3283

8" @ 251

Heeb 3087, Br lime 3200, Lans 3213

DST 3242-61, opn 1 hr., rec. 30' o&gcm

DST 3270-83, opn 1 hr., rec. 45' so

& gcm, 130#

5" @ 3270

CO to 3283

SO & W 2500A

S/2 $\frac{1}{4}$  boph PB 3265

2 $\frac{1}{4}$ /3253-59, 2500A

2 boph CO to 3283

Comp. 3 bopd

**COMPLETED**

County **Barton** State **Kansas**

Sec. **18** (Blk. Twp.) **19** (Sur. Rge.) **12W** Map No.

Operator **Sunray Oil**

Well No. **5** Farm **McIllrath**

Elev. Location **G W L NW SE**


**660** Ft. From **N** Line **SE**

**330** Ft. From **W** Line **Quarter**

1st. Report **MAR 18 1953**

Completion

Remarks

**Mouser Drlg. - Contr.**

Spudding Date **3-12-53**

Drlg. Data

**8" @ 251 drlg. 2665**

MAR 20 1959

Scout Cards	_____	AK
Land Small Map	_____	
Land Wall Map	_____	35
Tracings	.....	
France Map	.....	
Pierce Map	.....	
Misc.	_____	

Drig. Date

County Barton State Kansas

Sec. 18 (Blk. Twp.) 19 (Sur. Rgs.) 12W Map No.

Operator Sunray Oil

Well No. 5 Farm McIlirath

Elev. 1892 Location C W L NW SE


**COMPLETE**

660 Ft. From N Line SE

330 Ft. From W Line Quarter

Ist. Report

Completion MAY 20 1953

Remarks

Mouser Drlg. - Contr.

Spudding Date 3-12-53

Drlg. Data Oil well TD 3283

8" @ 251 Heeb. 3087 Br. lime 3200

Lans. 3213 DST 3242-61 open 1 hr.

Rec. 30' o & gcm DST 3270-83 open 1 hr.

Rec. 45' so & gcm 130# 5" @ 3270

CO to 3283 SO & W 2500 A S/ 2 1/2 boph

PB 3265 24/ 3253-59 2500 A

2 boph CO to 3283 Comp. 3 boph

SAVED

MAY 26 1952

Scout Cards	DD
Land Small Map	
Land Wall Map	33
Tracings	
Fence Map	
Home Map	

Orig. Data