

FORM 51
O.W.W.O.


Barton

KANSAS

Section 18 Township 19 Range 12W

Well No. #3 McIllrath

Company Sunray Oil Corporation

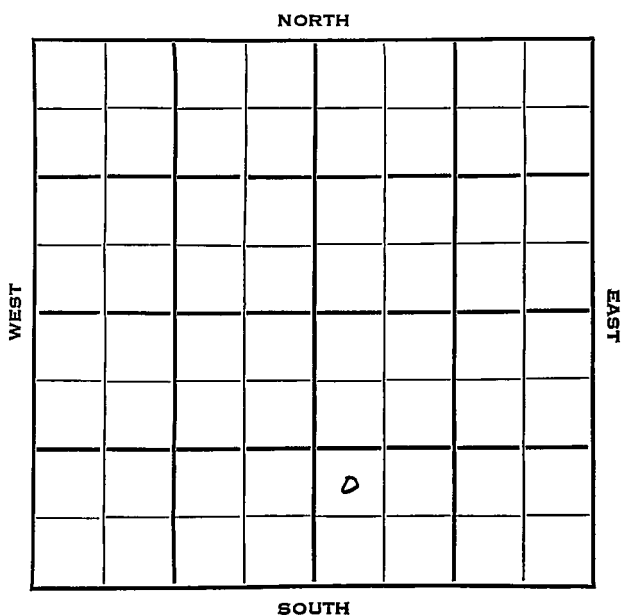

O.W.W.O.

Barton

KANSAS


 Sec. 18 Twp. 19 R. 12 W

 Well No. # 3 McIlrath Farm

Sunray Oil Company

Mouser Drlg. Contractor


 Ft. from N. Line

990
 Ft. from S. Line

 Ft. from E. Line

330
 Ft. from W. Line

NW SW SE

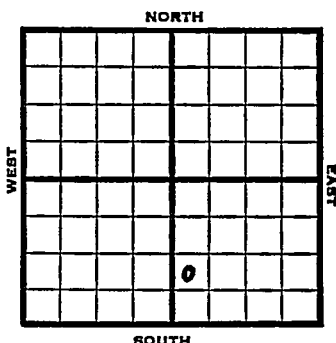

1953

Elev. 1871
~~1868~~ REPORT

2/11

Spud 2-7-53

8" @ 210 WOC

2/19

Drlg. 3080'

2/26

Heeb 3062, Lans 3186

DST 3230-45', 1 hr., 12' M, 0#

RTD 3258

5" @ 3251

3/11

Spud 2-7-53 D & A TD 3258

8" @ 210 Heeb 3062 Lans 3186

DST 3230-45 open 1 hr. rec 12' mud 0#

TD 3258 5" @ 3251 Heeb 3064

Tor. 3080' Br lime 3174 Lans 3187

GO to 3258 12 GPH 16/3249-54

5500 A 12 BO 8 BW 12 hr. SP 3242

40/3232-41 1500 A 11½ GO 22 GWPH

D & A

ABANDONED
O.W.W.O.

1953

4/8

Heeb 3064 Tor 3080 Br lime 3174

Lans. 3187' OTD 3258' 5" @ 3251

GO to 3258' Sd-frac.

4/16

Testing

4/23

"

OVER

1953

4/30 Testing

5/7 "

5/20 Oil Well

TD 3258

Heeb 3064, Tor-3080, Br lime 3174,

Lans 3187,

OTD 3258

5" @ 3251

CO to 3258 sd-frac,

Comp. 4 bopd 43% wtr.

COMPLETED

O.W.W.O.

County Barton State Kansas

Sec. 18 (Blk.) 19 (Sur.) 12W Map No.

Operator Sunray Oil

Well No. **3** Farm **McIlrath**

Elev. 1871 Location NW SW SE

0

FIRST REPORT

990 Ft. From S Line SE

330 Ft. From W Line Quarter

1st. Report APR 8 1953

Completion

Remarks (OWWO)

Spudding Date

Drig. Data N. Ft. Zarah Pool

Heeb. 3064 Tor. 3080 Br. lime 3174

Lens. 3187 OTD 3258 5" @ 3251

CO to 3258 sd-frac

J. G. McGEHEE

Scout Cards

mm

Land Small Map

Land Wall Map

Tracings

France Map

Pierce Map

Misc.

APR 10 1953

Orig. Data

County Barton State Kansas

Sec. 18 (Blk. Twp.) 19 (Sur. Rge.) 12W Map No.

Operator Sunray Oil

Well No. 3 Farm McIlrath

Elev.	Location	NW	SW	SE
-------	----------	----	----	----

FIRST REPORT

990 Ft. From S Line SE

330 Ft. From W Line Quarter

1st. Report FEB 11 1953

Completion

Remarks

Mouser Drlg. - Contr.

Spudding Date 2-7-53

Drig. Data

8th @ 210 WOC

J. G. McGEHEE

Scout Cards

Land Small Map

Land Wall Map

Tracings

France Map

Pierce Map

Index

FEB 13 1953

Orig. Date

J. G. McGEHEE

MAR 17 1953

Scout Cards

Land Small Map

Land Wall Map

Tracings

France Map


Discs Map

Misc.

Drig. Data

O.W.W.O.

County Barton State Kansas
 Sec. 18 (Blk. Twp.) 19 (Sur. Rge.) 12W Map No.
 Operator Sunray Oil
 Well No. 3 Farm McIllrath
 Elev. 1871 Location NW SW SE

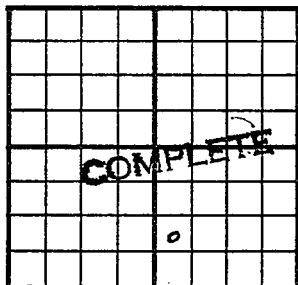

990Ft. From S Line SE
330Ft. From W Line Quarter

1st. Report Completion MAY 20 1953Remarks OWWOSpudding Date

O.W.W.O.

Drlg. Data Oil well TD 3258
Heeb. 3064 Tor. 3080 Br. lime 3174

Lans. 3187 OTD 3258 5" @ 3251

CO to 3258 sd-frac Comp. 4 bopd 43% wtr

J. G. McGEHEE

MAY 26 1953

Scout Cards	_____
Land Small Map	_____
Land Wall Map	_____
Tracings	_____
France Map	_____
Pierce Map	_____
Map	_____

Drig. Data