


Section 18 Township 19 Range 12W

Well No. #4 McIllrath

Company Sunray Oil Company

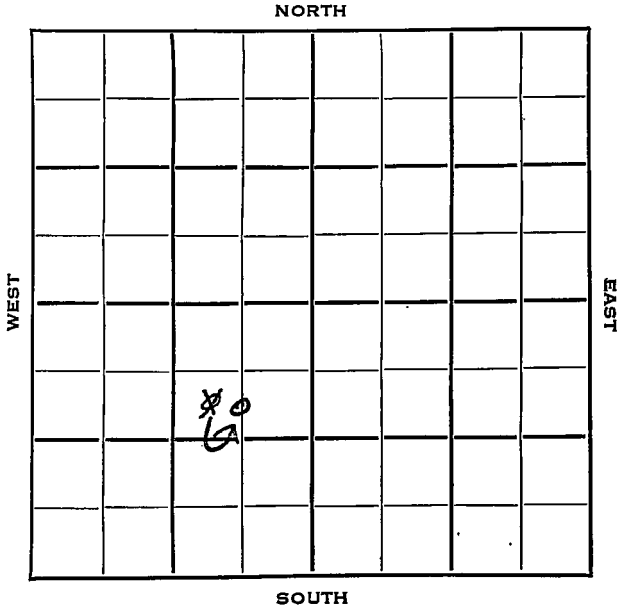

Sec. 18 Twp. 19 R. 12 W

Well No. # 4 McIlirath Farm

Sunray Oil Company

Mouser Drlg. Contractor

Ft. Zarah Pool


990 Ft. from N. Line

Ft. from S. Line

560
~~990~~ Ft. from E. Line

Ft. from W. Line

~~SW NE SW~~
CSL NESW

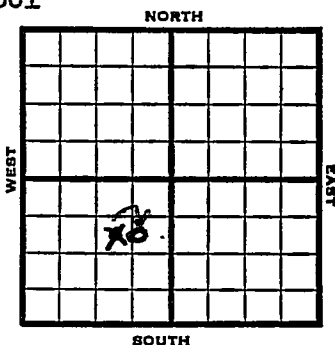

1953 Elev. 1889 : REPORT

2/25 Spud 2-22-53
8" @ 246

3/12 Heeb 3081 Lans 3205
DST 3266-79 RTD, 1 hr, 1500' gas,
DST 3247-79, 1 hr, 1140' gassy oil
1070# 5" @ 3278

3/19 CO 3276
24/3248-54,
5 BOPH 6 hrs. 1750A
13 BOPH 6 hrs.
POP

3/26 P/70 B0 12 hrs.

4/1 Spud 2-22-53
Oil Well
TD 3279'
8" @ 246'
Heeb 3081', Lans 3205,
DST 3266-79 open 1 hr. Rec 1500' gas
DST 3247-79 open 1 hr. Rec 1140' gassy
oil 1070#
5" @ 3278'
CO to 3276
24/ 3248-54 5 boph 6 hr. 1750A
13 boph 6 hr. P/ 70 bo 12hr.
Comp. 140 bopd

COMPLETED

K 11928

Map No. _____ Sec. 18 Twp. 19 R. 12W

Well No. 4 McIlrath

Sunray Oil Company

CORRECTION Contractor

C S L NE SW

SECTION PLAT

990 Ft. from N. Line

_____ Ft. from S. Line

560 Ft. from E. Line

_____ Ft. from W. Line

Barton County

RECORD

Location _____

Rig up _____

Drilling and Remarks:

Reported
SW NE SW

Cased _____ in., _____ ft.

Sand _____

Gas _____

Oil _____

Total Depth _____

PRODUCTION

1st 24 hrs. Nat. _____

1st 24 hrs. after shot _____

Gas _____ Cu. Ft.

Dry Hole _____

Abandoned _____

Date

MAR 4 1953 19

J. G. McGEHEE Scout

