

Section 18 Township 19 Range 12WWell No. 1 - GordonCompany Alpine Oil & Royalty

NORTH

		0					

WEST

EAST


SOUTH

Barton

KANSAS ✓

Sec. 18 Twp. 19 R. 12 WWell No. # 1 Gordon FarmAlpine Oil & Royalty CompanyQuaker Drlg. Contractor330 Ft. from N. Line Ft. from S. Line990 Ft. from E. Line Ft. from W. Line

NW NE NW

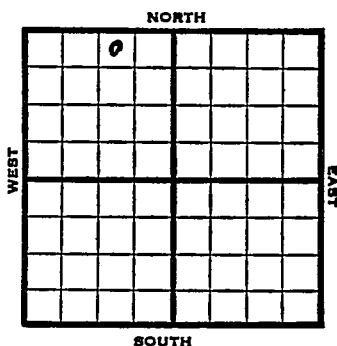

1952 Elev. 1881' REPORT

12/30 Spud 12-28-52
8" @ 245 WOC

1/1 WOC

1/8 Heeb 3082 Br 1 3189 Lans 3203 DST
3205 - 36 1 Hr. 4'm Ø32741/14 Spud 12-28-52
D&A TD 3440
8" @ 245Heeb 3082, Br lime 3189, Lans
3203DST 3205-36, opn 1 hr., rec.
4' mudDST 3246-78, opn 1 hr., rec.
270' gcm & sw 1040#DST 3331-85, opn 1/2 hr., rec.
15' mud, 760#

TD 3440

D&A

ABANDONED

County Barton State Kansas
 Sec. 18 (Blk. Twp.) 19 (Sur. Rge.) 12W Map No.
 Operator Alpine Oil & Royalty
 Well No. 7 Farm Gordon
 Elev. _____ Location NW NE NW

		0					

FIRST REPORT

330 Ft. From N Line NW
990 Ft. From E Line Quarter
 1st. Report DEC 30 1952
 Completion _____
 Remarks _____
Quaker Drlg. - Contr.
 Spudding Date 12-28-52

Drlg. Data

8" @ 245 WOC

J. G. McGEHEE

J. G. McGEHEE