

DX 78-1


Barton

KANSAS

Section 18 Township 19 Range 12W

Well No. #1 Hermes

Company Shelly-Miller

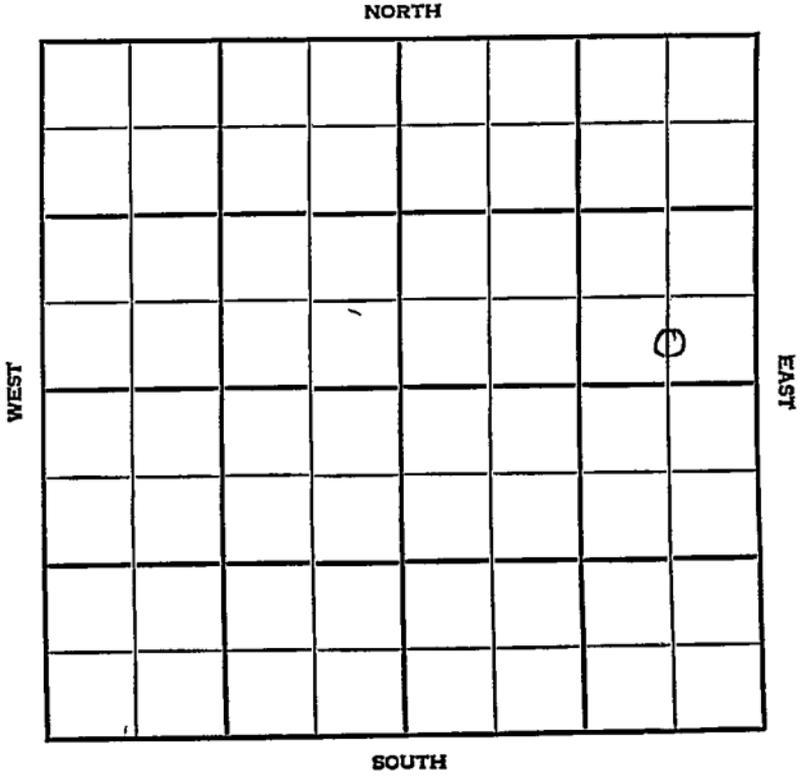

HOT FILE

Barton

KANSAS

SEC.	TWP.	R.
18	19	12 W

WELL NO. # 1 Hermes FARM
 COMPANY

CONTRACTOR Shelley-Miller

Co. tools

N. Ft. Zarah Pool


_____ Ft. from N. Line

330 _____ Ft. from S. Line

660 _____ Ft. from E. Line

_____ Ft. from W. Line

C S $\frac{1}{2}$ SE NE

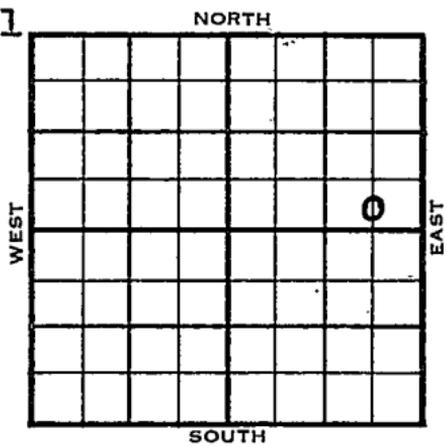

SDX FO & Offset

	ELEVATION	REPORT
1955	1900 KB	

6/1

Location

6/9

Spud 6-2-55
 8-5/8" @ 211 w/125
 Anhy 763'
 Drlg. 2684'

6/15

Comm 6-2-55
 Anh 763, H 3094, B1 3207, L 3221,
 C 3467, TD 3490
 8 5/8" @ 211/125 DST 3464-90
 open 1 hr Rec 20' mud 25' o & gcm
 980#
 D & A

ABANDONED

County Barton Elev. 1900 KB

Sec. 18 Twp. 19 Rge. 12W


Company Shelly-Miller

Farm Name Hermes No. 1

TOPS	DEPTH	LOG	DATUM
Anh.	763		
TP			
H.	3094		1194
Tr.			
Dg.			
BL.	3207		1307
L.	3221		1321
K.C.			
B.K.C.			
Ce.			
C.	3467		1567
M.			
M.			
K.			
Mz.			
Ms.			
V.			
S.			
S.			
A			
R.			
PE.			
G.			
TD.	3490		

Loc. in Sec. C S $\frac{1}{2}$ SE NE

Geol. _____
 Contr. _____
 Co. tools _____
 -Pool _____
 N: Ft. Zarah _____

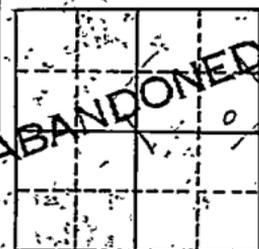

Date Comm. 6-2-55 JUN 15 1955
8 5/8" @ 211/125 DST 3464-90 open 1 hr.

Rec. 20' mud 25' o & gcm 980#

D & A

3490
 1900

 1590

Co.
 Lse.
 No.
 Sec.
 T.
 R.