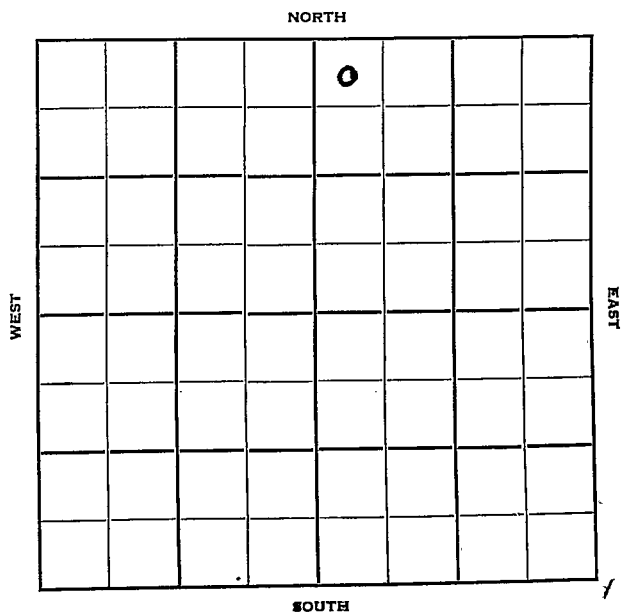


Section 18 Township 19 Range 12 WWell No. # 1 HermesCompany Sunray Oil

Barton

KANSAS

Sec. 18 Twp. 19 R. 12W

Well No. #1 Hermes Farm

Sunray Oil Company

Stickle Drlg. - Contr. Contractor

Frank Pool


330' Ft. from N. Line

Ft. from S. Line

Ft. from E. Line

330' Ft. from W. Line

NW NW NE

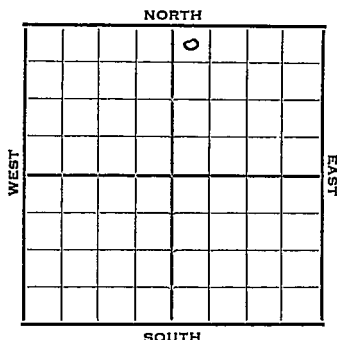

1952

Elev. 1857'

REPORT

4/23

Spud 4-18-52

8" @221'

Anhy 720

Drlg. 1545'

4/30

Heeb. 3055

Br Li 3162

Lans. 3175

DST 3192-3219, 1 hr. 4' m 0#

DST 3230-52, 1 hr. 15 mins. 125' HO&GCM

50% oil 780' gas

DST 3301-27'

5/7

DST 3301-27, 1 hr, 8' M 0#

Cherty Cong 3426' RTD 3447'

5" @ 3364' WOCT

5/14

CO 24/3246-51 5 galoph 1000A

4 to 6 BWPH No oil Sqz off

5/21

Spud 4-18-52

D & A TD 3447' 8" @ 221

Anhy 720' Heeb 3055' Br li 3162'

Lans. 3175'

DST 3192-3219 open 1 hr. rec 4' mud

DST 3230-52 open 1 hr. 15 min, rec 125'

HO & GCM, 50% oil, 780' gas.

DST 3301-27 open 1 hr. rec 8' mud

Cong. 3426' TD 3447' 5" @3364'

24/3246-51 5 GOPH 1000 A 4 to 6 BWPH

no oil 8/3243-45 dry 8/3245-47


300 A 1 GO 24 GWPH SP 3230

15/3203-08 SSO 500 A DP to 3242'

23/3230-38 water. D & A

ABANDONED

County **Barton** State **Kansas**
 Sec. **18** (Blk.) **19** (Sur.) **12W** Map No.
 Operator **Sunray Oil**
 Well No. **1** Farm **Hermes**
 Elev. Location **NW NW NE**

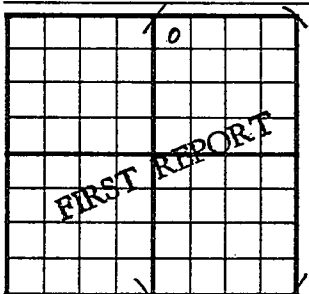

330 Ft. From **N** Line **NE**
330 Ft. From **W** Line Quarter
 Ist. Report **APR 23 1952**
 Completion
 Remarks

Stickle Drlg. - Contr.

Spudding Date **4-18-52**

Drlg. Data **Frank Pool**

8" @ 221 Anhy 720 drlg. 1545

J. G. McGEHEE

County	Barton		State	Kansas
Sec.	18	(Blk.) (Twp.)	19	(Sur.) (Rge.) 12W Map No.
Operator	Sunray Oil			
Well No.	1	Farm	Hermes	
Elev.	1857	Location	NW NW NE	

330 Ft. From	N Line	NE
330 Ft. From	W Line	Quarter
Ist. Report		
Completion	MAY 21 1952	
Remarks	Frank Pool	
	Stickle Drlg. - Contr.	
Spudding Date	4-18-52	
Drlg. Data	D & A TD 3447	

ABANDONED

8" @ 221 Anhy 720 Heeb. 3055
 Br. lime 3162 Lens. 3175 DST 3192-3219
 open 1 hr. Rec. 4' mud DST 3230-52
 open 1 hr. 15 min. Rec. 125' ho & gcm
 50% oil 780' gas DST 3301-27
 open 1 hr. Rec. 8' mud Cong. 3426
 TD 3447 5" @ 3364 24/ 3246-51
 5 goph 1000 A 4 to 6 bwph no oil
 8/ 3243-45 dry 8/ 3245-47 300 A
 1 go 24 gwph SP 3230 15/ 3203-08
 SSO 500 A DE to 3242 23/ 3230-38
 water D & A

J. G. McGEHEE