


FORM 51

Section 18 Township 19 Range 10W

Well No. #1 Apel

Company Greenland Drlg.

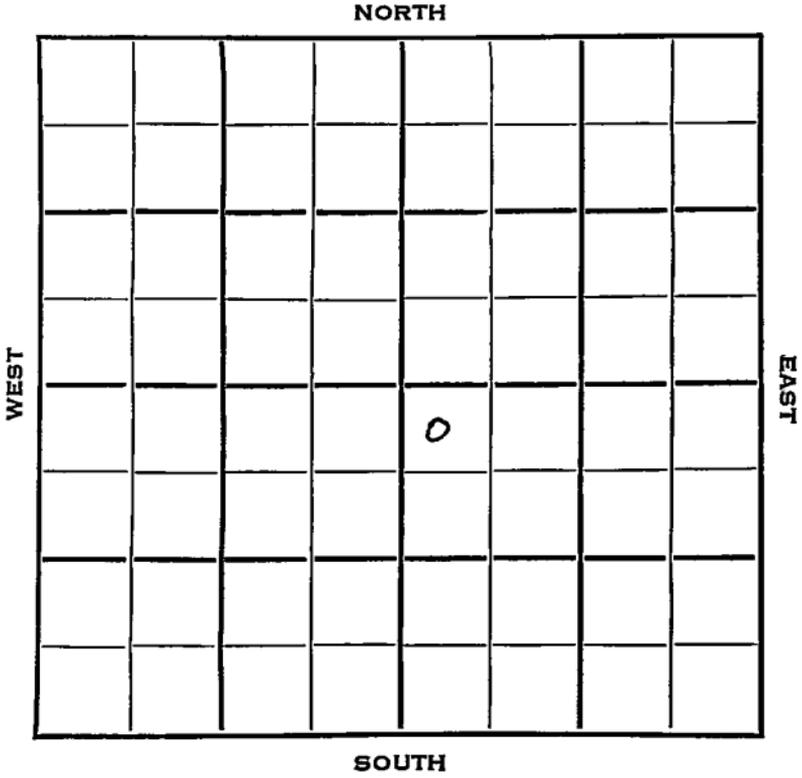

Rice

KANSAS

SEC.	TWP.	R.
18	19	10W


WELL NO. #1 Apel FARM

COMPANY Greenland Drlg.

CONTRACTOR Greenland Drlg.

Chase-Silica Pool NORTH

330 Ft. from N. Line  
 Ft. from S. Line  
 Ft. from E. Line  
 330 Ft. from W. Line

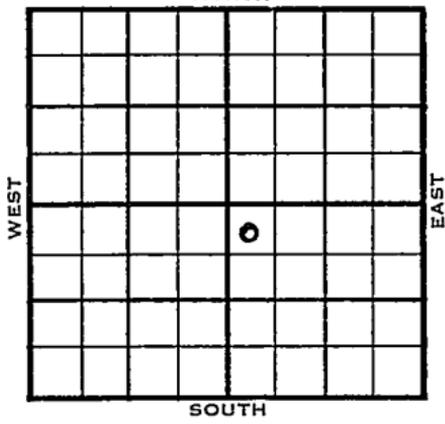

NW NWSE

	ELEVATION	REPORT
1954	1771'	

2/10 Spud 2-1-54  
 8" @ 172'  
 Anhy 514', Heeb 2871', Br. Lime 2991'  
 Lans 3008'  
 DST 3015'-36' opn 1 hr, rec 64' socm  
 1075#  
 DST 3102'- opn 1 hr, rec 80' o & gcm  
 475#

2/17 Spud 2-1-54  
 D&A  
 TD 3355'  
 8" @ 172'  
 Anhy 514', Heeb 2871', Br. lime 2991',  
 Lans 3008'  
 DST 3015'-36', opn 1 hr., rec. 64'  
 socm, 1075#  
 DST 3102- opn 1 hr., rec. 80'  
 o & gcm, 475#  
 Cong. 3312', Arb. 3352'  
 TD 3355'  
 D&A

ABANDONED



County Rice State Kansas  
 Sec. 18 (Blk. 1 Twp.) 19 (Sur. 10W Rge.) Map No.  
 Operator Greenland Drlg.  
 Well No. 1 Farm Apel  
 Elev. 1771 Location NW NW SE


330 Ft. From N Line SE  
330 Ft. From W Line Quarter  
 Ist. Report  
 Completion FEB 17 1954  
 Remarks Chase-Silica Pool  
Greenland Drlg. - Contr.  
 Spudding Date 2-1-54

Drlg. Data D & A TD 3 355  
8" @ 172 Anhy 514 Heeb. 2871  
Br. lime 2991 Lans. 3008 DST 3015-36  
open 1 hr. Rec. 64' socom 1075#  
DST 3102- open 1 hr. Rec. 80' o & gcm  
475# Cong. 3312 Arb. 3352 TD 3355

D & A