


KANSAS

Section 18 Township 19 Range 10WWell No. #1 ManszCompany Westgate-Greenland et al.
Silica Pool

NORTH

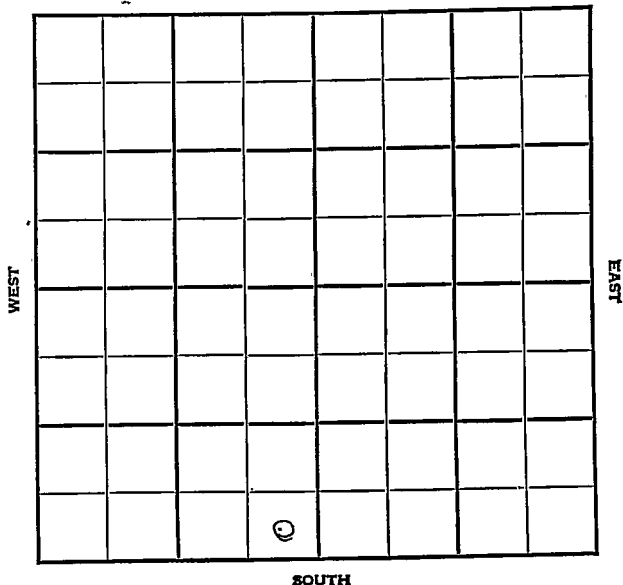




Sec. 18 Twp. 19 R. 10W

Well No. #1 Mansz Farm

Westgate-Greenland et al Company
Silica

 Ft. from N. Line
330 Ft. from S. Line
330 Ft. from E. Line
 Ft. from W. Line

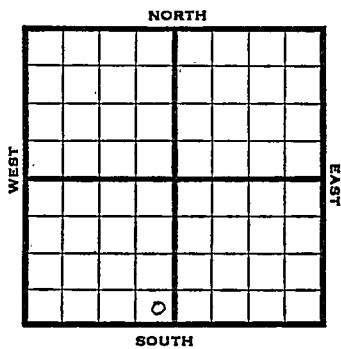

SE SW

1948 Elev. 1774 REPORT

4/7	Location
4/14	8" @ 162' Drlg. 1710'
4/21	Lansing 3025' Drlg. 3028'
4/28	Arbuckle 3322' TD 3328' SO 5" @ 3324' RUST
5/5	"
5/12	"
5/19	TD 3334' 1500 Acid
5/26	"
6/1	"
6/9	"
6/16	"
6/23	"

OVER

1948

6/30 Arbuckle 3322'
5" @ 3324'
1500 Acid
Pump 95 Pot oil
Gr. 42°
TD 3334'

COMPLETED

Map No. _____ Sec. 18 Twp. 19 R. 10W

Well No. 1 Mansz

Westgate-Greenland etal. Company

FIRST REPORT

Contractor

SE SW


SECTION PLAT

Ft. from N. Line

330 Ft. from S. Line

330 Ft. from E. Line

Ft. from W. Line

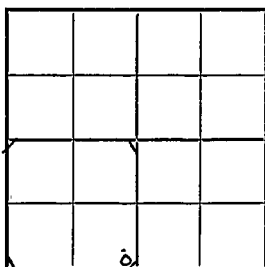

Rice County

Location X

Rig up _____

Drilling and Remarks:

RECORD

Cased _____ in., _____ ft.

Sand _____

Gas _____

Oil _____

Total Depth _____

PRODUCTION

1st 24 hrs. Nat. _____

1st 24 hrs. after shot _____

Gas _____ Cu. Ft.

Dry Hole _____

Abandoned _____

Date

APR 7 1948 19 S. J. LEWIS Scout

Misc. Small Maps _____
Cards _____
Tracing _____
France Map _____
Scarborough Map _____
Pierce Map _____
Geological Dept. _____
Pierce Plat Book _____

Map No. 46 Sec. 18 Twp. 19 R. 10WWell No. 1 ManszWestgate-Greenland et al.

Company


COMPLETE

Contractor

SE SW

E1.1274

SECTION PLAT

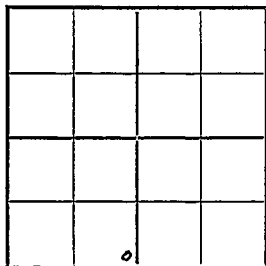 Ft. from N. Line330 Ft. from S. Line330 Ft. from E. Line Ft. from W. Line

Rice County

Location Rig up

Drilling and Remarks:

Cor & 33225" @ 33241000 acidRun 95 P & D
etc42 e h

RECORD

Cased in., ft.Sand Gas Oil Total Depth 3334

PRODUCTION

1st 24 hrs. Nat. 1st 24 hrs. after shot Gas Cu. Ft.Dry Hole Abandoned

Date

JUN 30 1948

19

S. J. LEWIS

Scout

Misc. Small Maps
Cards
Tracing
France Map
Scarborough Map
Pierce Map
Geological Dept.
Pierce Plat Book