


Section 18 Township 19 Range 10-W

Well No. #1 Ehardt

Company E Adair

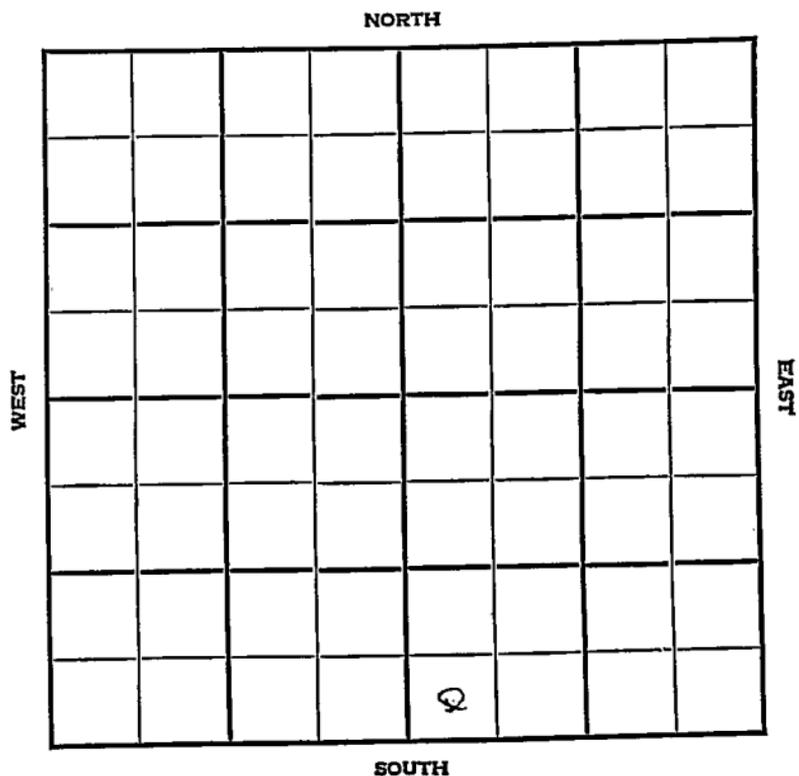



Sec. 18 Twp. 19 R. 10W

Well No. #1 Ebhardt Farm
E. Adair Company

Silica Pool


_____ Ft. from N. Line

330' Ft. from S. Line

_____ Ft. from E. Line

330' Ft. from W. Line

SW SE

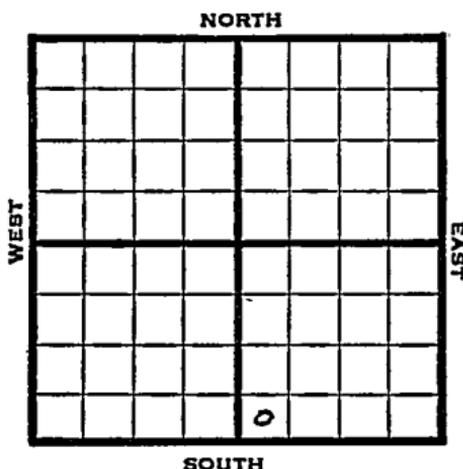

1948

Eli 1771'

REPORT

- 6/23 8" @ 180'
WOC
- 6/29 Lansing 3029'
Arbuckle 3328'
TD 3331'
5" @ 3326'
RUST
- 7/8 "
- 7/14 "
- 7/21 "
- 7/28 "
- 8/4 TD 3358' - 100' Wtr
- 8/11 " " " "
- 8/18 Arbuckle 3328'
TD 3368'
Aband.

ABANDONED

Map No. _____ Sec. 18 Twp. 19 R. 10W

Well No. 1 Ebhardt

E. Adair Company

FIRST REPORT

Contractor

SW SE


SECTION PLAT

_____ Ft. from N. Line

330 Ft. from S. Line

_____ Ft. from E. Line

330 Ft. from W. Line

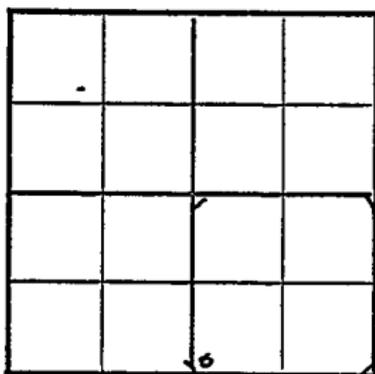

Rice County

Location _____

Rig up _____

Drilling and Remarks:

8" @ 180 WOC

RECORD

Cased _____ in., _____ ft.

Sand _____

Gas _____

Oil _____

Total Depth 57

PRODUCTION

1st 24 hrs. Nat. _____

1st 24 hrs. after shot _____

Gas _____ Cu. Ft.

Dry Hole _____

Abandoned _____

Date

JUN 23 1948 19 S. J. LEWIS Scout

