

Section 18 Township 19 Range 2W

Well No. #1 Clark

Company Geo. Hess et al

NORTH

8

							0

SOUTH

WEST

EAST

McPherson McPherson

KANSAS

SEC.	TWP.	R.
18	19	2 W

WELL NO.

1 Clark

FARM

COMPANY

Geo. Hess et al

CONTRACTOR

Mallard Drlg.

Wildcat

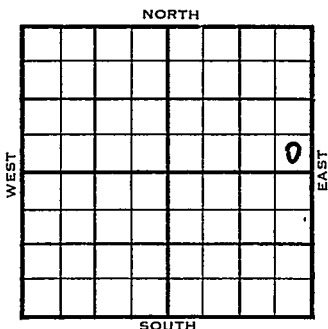
Ft. from N. Line

330 Ft. from S. Line

330 Ft. from E. Line

Ft. from W. Line

SE SE NE



1953

ELEVATION

1516'

REPORT

11/11

MIR

11/18

Spud 11-10-53

D&A

TD 3075'

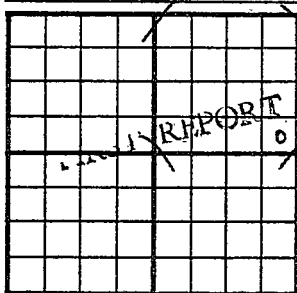
8" @ 150'

KC 2343', Miss 3021'

TD 3075'

D&A

ABANDONED

County McPherson State KansasSec. 18 (Blk. Twp.) 19 (Sur. Rge.) 2W Map No.Operator Geo. Hess et al.Well No. 1 Farm ClarkElev. Location SE SE NE330 Ft. From S Line NE330 Ft. From E Line Quarter1st. Report NOV 11 1953

Completion

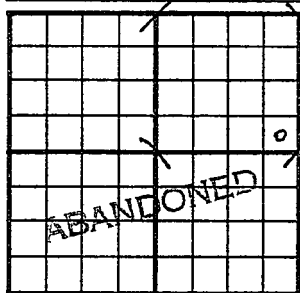
Remarks

Mallard Drlg. - Contr.

Spudding Date

Drlg. Data WildcatM I R

J. G. McGEHEE

County McPherson State KansasSec. 18 (Blk.
Twp.) 19 (Sur.
Rge.) 2W Map No.Operator Geo. Hess et al.Well No. 1 Farm ClarkElev. 1516 Location SE SE NE330 Ft. From S Line NE330 Ft. From E Line Quarter1st. ReportCompletion NOV 18 1953Remarks WildcatMallard Drlg. - Contr.Spudding Date 11-10-53Drlg. Data D & A TD 30758" @ 150 KC 2343 Miss. 3021 TD 3075D & A

J. G. McGEHEE