


DX 78-1 McPherson

KANSAS

Section 18 Township 19 Range 2W

Well No. #1 Enberg

Company Mallard Drlg & Pack Oil

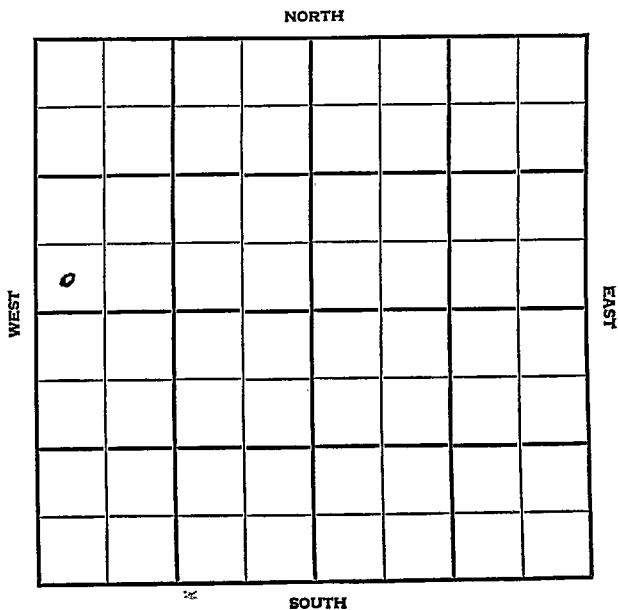

SEC.	TWP.	R.
18	19	2W

WELL NO.

#1 Enberg.

FARM

COMPANY

Mallard Drilg. & Pack Oil

CONTRACTOR

Mallard.

Chindberg Pool

NORTH

Ft. from N. Line

330


Ft. from S. Line

Ft. from E. Line

330

Ft. from W. Line

SW SW NW

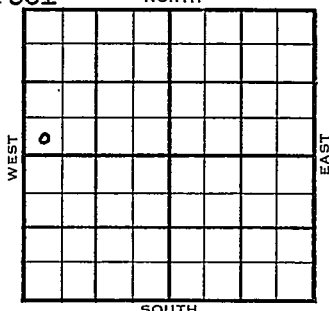

1954	ELEVATION 1544'	REPORT
------	--------------------	--------

11/3

8" @ 150'

WORT.

12/1

Spud 11-2-54

Oil Well

TD 3016'

8" @ 150'

Lans 2335' Miss 2979'

TD 2996'

5" @ 2995'

CO to 2996'

B/ 3 go 39 gwph DD 3016 FU 300' oil

lots of wtr. S/ 7½ bo wtr. 1½ hr.

P/ 70 bfpd.

Comp 25 bopd. 40 bw.

COMPLETED

County McPherson State KansasSec. 18 (Blk.) 19 (Sur.) 2W Map No.Operator Mallard Drlg. & Pack OilWell No. 1 Farm EnbergElev. Location SW SW NW

FIRST REPORT

330 Ft. From S Line NW330 Ft. From W Line Quarter1st. Report NOV 3 1954

Completion

Remarks

Mallard Drlg. - Contb.

Spudding Date

Drlg. Data Chindberg Pool8" @ 150 WORT

FABEN GILSTRAP

FABEN GILSTRAP