

Section 18 Township 19 Range 16W

Well No. #1 Fokkerts

Company Ed Adair & Graham

*3*

NORTH

			0				

WEST

EAST

SOUTH

Sec. 18 Twp. 19 R. 16 W

Well No. # 1 Folkerts Farm  
Ed Adair & Graham Company  
Adair Contractor  
Wildcat


330 Ft. from N. Line

Ft. from S. Line

330 Ft. from E. Line

Ft. from W. Line

NE NE NW

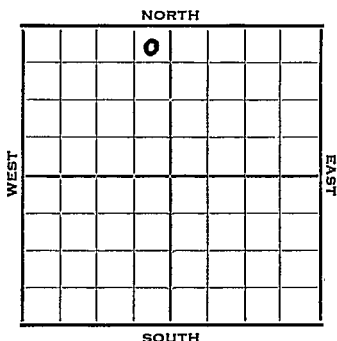

1952 Elev. 2093' REPORT

7/23 Spud 7-18-52  
8" @ 260' Anhy 1171-90'  
Drlg. 1606'

7/30 Topeka 3178 Heeb. 3435  
Br Li 3457  
Drlg. 3465'

8/6 Spud 7-18-52  
D & A TD 3875' 8" @ 260'  
Anhy 1171' Top. 3178' Heeb 3435'  
Br. lime 3457' Lans. 3495'  
B KC 3734' Cong. 3831' Arb. 3860'  
TD 3875'  
D & A

**ABANDONED**


County Rush State Kansas

Sec. 18 (Blk. Twp.) 19 (Sur. Rge.) 16W Map No.

Operator Ed Adair & Graham

Well No. 1 Farm Folkerts

Elev. \_\_\_\_\_ Location NE NE NW

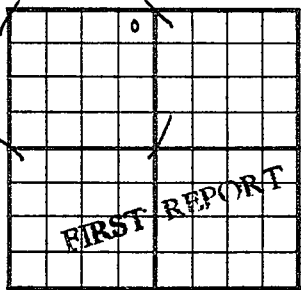

550 Ft. From N Line NW

330 Ft. From E Line Quarter

Ist. Report JUL 23 1952

Completion \_\_\_\_\_

Remarks \_\_\_\_\_

Adair - Contr.

Spudding Date 7-18-52

Drlg. Data Wildcat

8" @ 260 Anhy 1171-90 drlg. 1606

County Rush State KansasSec. 18 (Blk.  
Twp.) 19 (Sur.  
Rge.) 16W Map No.Operator Ed Adair & GrahamWell No. 1 Farm FolkertsElev. 2093 Location NE NE NW


330 Ft. From N Line NW330 Ft. From E Line Quarter

1st. Report

Completion AUG 6 1952Remarks WildcatAdair - Contr.Spudding Date 7-18-52Drilg. Data D & A TD 38758" @ 260 Anhy 1171 Top. 3178Heeb. 3435 Br. lime 3457 Lans. 3495B KC 3734 Cong. 3831 Arb. 3860TD 3875D & A