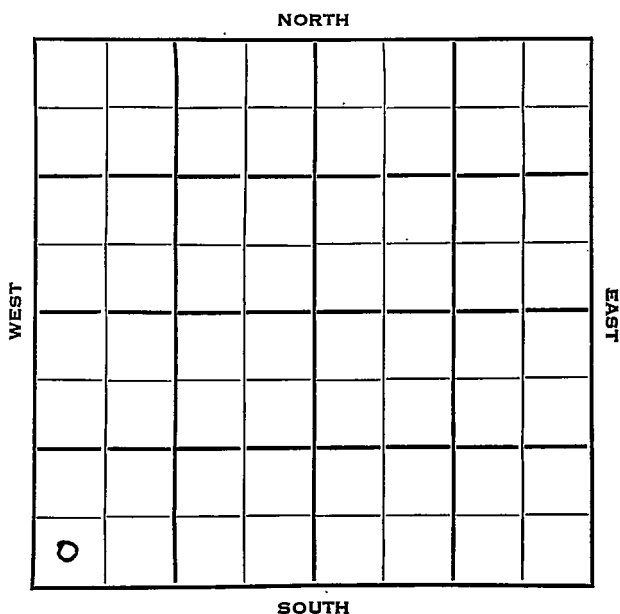


Section 19 Township 19 Range 11WWell No. #1 RoblCompany Aikins & Owens

Barton

KANSAS

19

19

11W

Sec. _____ Twp. _____ R. _____

Well No. #1 Robl Farm _____Aikins & Owens

Company _____

Hartman

Contractor _____

Ft. from N. Line

330


Ft. from S. Line

Ft. from E. Line

330

Ft. from W. Line

SW SW SW

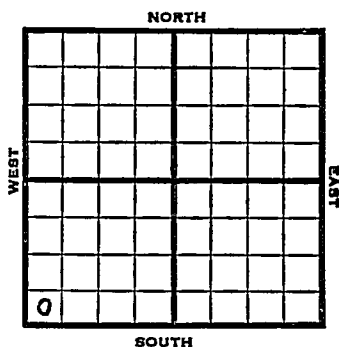

1953

Elev. 1798'

REPORT

7/29

Spud 7-22-53

Anhy 590

Drlg. 2751'

8/26

Spud 7-22-53

Oil Well

TD 3400

Anhy 590

8" @ 161

Top 2688; Heeb 2949, Br line 3067,

Lans 3086

DST 3088-3114, opn 1 hr., rec. 730' gas, 55' o & gcm, 100#

DST 3139-86, opn 1 hr., rec. 70' wtr 1120#

DST 3305-35, opn 1 hr., rec. 90' gas, 50' ho & gcm, 120#

Arb. 3388

TD 3400

5" @ 3399

CO to 3354, 36/3110-16

B/1/2 boph, 12 hrs., 2500A, S/4 boph

Comp. 70 bopd

COMPLETED

County Barton State Kansas

Sec. 19 (Blk. Twp.) 19 (Sur. Rge.) 11W Map No.

Operator **Aikins & Owens**

Well No. **1** Farm **Robt**

Elev. 1798 Location SW SW SW

FIRST REPORT

330 Ft. From S Line SW

330 Ft. From W Line Quarter

1st. Report JUL 9 1953

Completion _____

Remarks

Hartman - Contr.

Spudding Date 7-22-53

Drlg. Data

Anhy 590 drlg. 2751

J. G. McGEHEE

County Barton State Kansas
 Sec. 19 (Blk. 19) (Sur. 11W) (Rge.) Map No.
 Operator Aikins & Owens
 Well No. 1 Farm Robl
 Elev. 1798 Location SW SW SW

0					

330 Ft. From S Line SW

330 Ft. From W Line Quarter

Ist. Report

Completion AUG 26 1953

Remarks

Hartman - Contr.

Spudding Date 7-22-53

Drlg. Data Oil well TD 3400

Anhy 590 8" @ 161 Top. 2688

Heeb. 2949 Br. lime 3067 Lans. 3086

DST 3088-3114 open 1 hr. Rec. 730' gas

55' o & gcm 100# DST 3139-86 open 1 hr

Rec. 70' wtr. 1120# DST 3305-35

open 1 hr. Rec. 90' gas 50' ho & gcm

120# Arb. 3388 TD 3400 5" @ 3399

CO to 3354 36/ 3110-16 B/ $\frac{1}{2}$ goph

12 hr. 2500 A S/ 4 boph

Comp. 70 bopd

J. G. McGEHEE