

Section 19 Township 19 Range 12W

Well No. 1 McIlrath

Company Alpine Oil & Royalty

NORTH

			o				
	2						

WEST

EAST

SOUTH

W

12
12
12

Barton

KANSAS ✓

Sec. 19 Twp. 19 R. 12 W

Well No. # 1 McIlrath Farm

Alpine Oil & Royalty Company

Contractor

Wildcat


330 Ft. from N. Line

Ft. from S. Line

330 Ft. from E. Line

Ft. from W. Line

NE NE NW

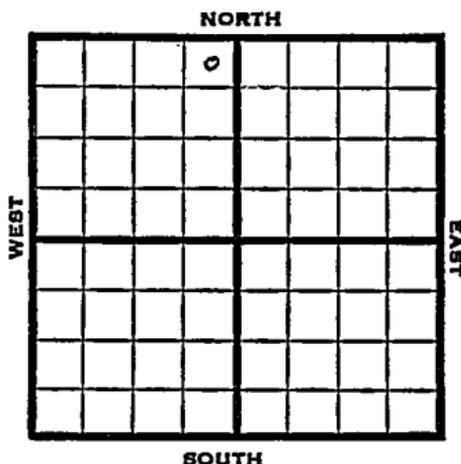

1951

Elev. 1829'

REPORT

8/1 Location

9/12 Spud 8-1-51
 Oil well TD 3430' 8" @ 179
 Heeb 3016' Br. lime 3126' KC 3142'
 DST 3146-3211 open 45 min. rec 2190'
 oil
 Cong. 3390' Arb. 3406-10'
 5" @ 3408 TD 3430' PB 3264'
 2 1/2 / 3208-14 FU 1050' oil 12 hr.
 S/2 BOPH 250 A F/20 BOPH
 Comp. F/346 BOPD

COMPLETED

County Barton State Kansas

Sec. 19 (Blk. Twp.) 19 (Sur. Rge.) 12W Map No.

Operator Alpine Oil & Royalty

Well No. 1 Farm McIlrath

Elev. Location NE NE NW

		0			

FIRST REPORT

330 Ft. From N Line NW

330 Ft. From E Line Quarter

Ist. Report AUG 1 1951

Completion _____


Remarks _____

Spudding Date _____

Drlg. Data Wildcat

Location

J. E. TYRA

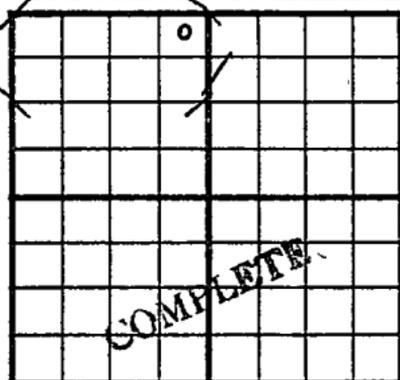County Barton State KansasSec. 19 (Blk. Twp.) 19 (Sur. Rge.) 12W Map No.Operator Alpine Oil & RoyaltyWell No. 1 Farm McIllrathElev. 1829 Location NE NE NW330 Ft. From N Line NW330 Ft. From E Line Quarter

1st. Report _____

Completion SEP 12 1951Remarks WildcatSpudding Date 8-1-51Drlg. Data Oil well TD 34308" @ 179 Heeb. 3016 Br. lime 3126KC 3142 DST 3146-3211 open 45 min.Rec. 2190' oil Cong. 3390 Arb. 3406-105" @ 3408 TD 3430 PB 3264 24/ 3208-14FU 1050' oil 12 hr. S/ 2 boph 250 AF/ 20 boph Comp. F/ 346 bopd

J. E. TYRA