


Section 19 Township 19 Range 12 W

Well No. # 1 Harris

Company Trans-Era

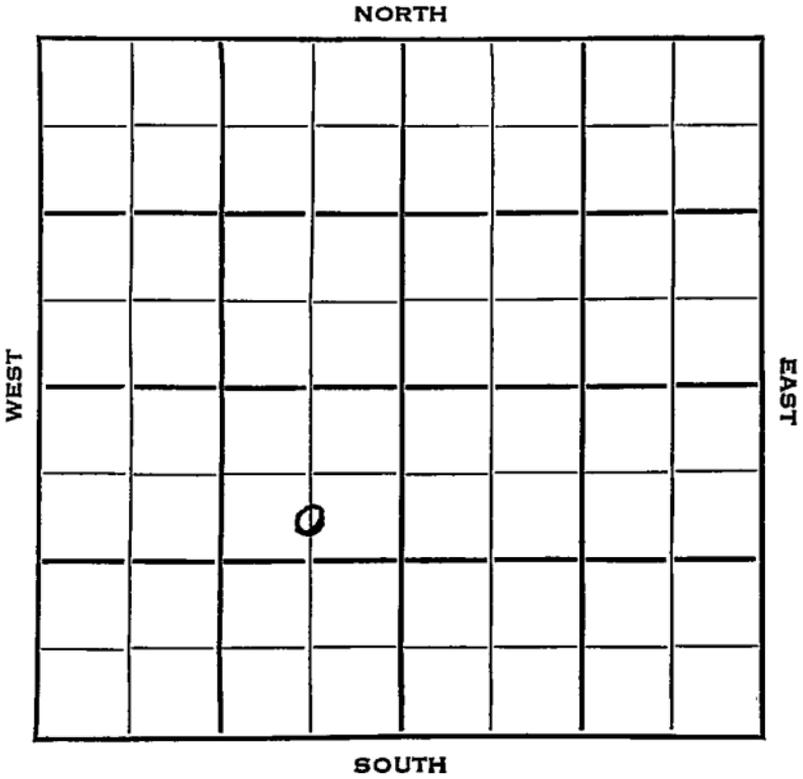

Sec. 19 Twp. 19 R. 12W

Well No. #1 Harris Farm \_\_\_\_\_

Trans-Era Company \_\_\_\_\_

Trans-Era Contractor \_\_\_\_\_


990 Ft. from N. Line

\_\_\_\_\_ Ft. from S. Line

660 Ft. from E. Line

\_\_\_\_\_ Ft. from W. Line

C S L NE SW

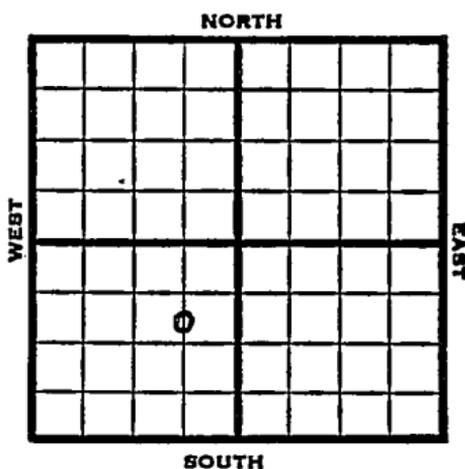

1953 Elev. 1828' REPORT

4/15 Spud 4-8-53  
8" @ 180  
Anhy 680  
Drlg. 2510'

4/23 Heeb 3027' Br li 3141' KC 3154  
DST 3159-84, 1 hr, 10' M Off  
DST 3306-66, 1 hr, 150' M Off  
Arb. 3421' RTD 3423' 5" @ 3422

4/30 DD 3431 1000 A S/1 1/2 BOPH Plug 3303  
24/3288-94 1000 A CO 3431  
Plug 3225 24/3206-07 500 A

5/7 Drove plug 3431  
PB 3195 16/ 3178-82 500 A S/ O & W  
CO 3431 S/ 30 Bopd.

5/21 P/11 bfpd 95% w

5/28 N.R.

6/3 NR  
6/10 Spud 4-8-53

D & A  
TD 3431'  
8" @ 180'  
Anhy 680, Heeb 3027, Br. Lime 3141,  
KC 3154,  
DST 3159-84 opn 1 hr, rec 10' mud Off  
DST 3306-66 opn 1 hr, rec 150' mud Off

OVER

1953

Information brought forward.

6/10

Arb 3421

TD 3423

5" @ 3422'

DD 3431'

1000 A S/  $1\frac{1}{2}$  boph SP 3303 24/ 3288

94 1000 A CO to 3431 SP 3225

24/ 3206-09 500 A DP 3431 PB

3195

16/ 3178-82 500 A S/ o & w CO

to 3431 S/ 30 boph P/ 11 bfpd

95% wtr.

P/ 8 bopd 90% wtr.

D & A

**ABANDONED**

County **Barton** State **Kansas**

Sec. **19** (Blk. Twp.) **19** (Sur. Rgs.) **12W** Map No.

Operator **Trans-Era**

Well No. **1** Farm **Harris**

Elev. Location **C S L NE SW**


**990** Ft. From **N** Line **SW**

**660** Ft. From **E** Line **Quarter**

Ist. Report **APR 15 1953**

Completion

Remarks

**Trans-Era - Contr.**

Spudding Date **4-8-53**

Drlg. Data


**8" @ 180 Anhy 680 drlg. 2510**

APR 17 1953

Scott Cards	AD
Land Small Map	
Land Wall Map	B
Tracings	
France Map	
Pierce Map	
Misc.	

Orig. Data

County Barton State Kansas  
 Sec. 19 (Blk. Twp.) 19 (Sur. Rge.) 12W Map No.  
 Operator Trans-Era  
 Well No. 1 Farm Harris  
 Elev. 1828 Location C S L NE SW

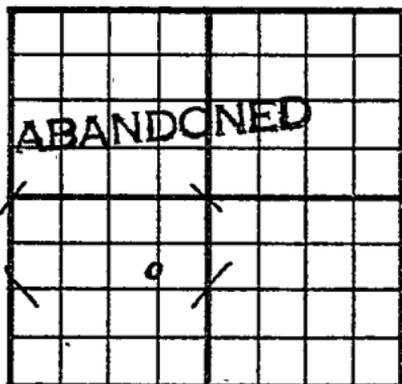

990 Ft. From N Line SW  
660 Ft. From E Line Quarter

Ist. Report

Completion JUN 10 1953

Remarks

Trans-Era - Contr.

Spudding Date 4-8-53

Drlg. Data D & A TD 3431

8" @ 180 Anhy 680 Heeb. 3027

Br. line 3141 KC 3154 DST 3159-84

open 1 hr. Rec. 10' mud 0# DST 3306-

66 open 1 hr. Rec. 150' mud 0#

Arb. 3421 TD 3423 5" @ 3422 DD 3431

1000 A S/ 1 1/2 boph SP 3303 24/ 3288-

94 1000 A CO to 3431 SP 3225

24/ 3206-09 500 A DP 3431 PB 3195

16/ 3178-82 500 A S/ o & w CO to 3431

S/ 30 boph P/ 11 bfpd 95% wtr.

P/ 8 bopd 90% wtr.

D & A

J. G. McGEHEE

JUN 16 1953

Scout Cards .....	
Land Small Map .....	
Land Wall Map .....	65
Tracings .....	
Tracing Map .....	
Home Map .....	
Disc. ....	