

Section 19 Township 19 Range 12WWell No. #1 McIlrath (B)Company Alpine Oil

NORTH

				0			

WEST

EAST

SOUTH

2

Barton

KANSAS

Sec. 19 Twp. 19 R. 12 W

Well No. # 1 McIlrath (B) Farm

Alpine Oil

Company

Contractor

330

Ft. Zarah

Ft. from N. Line


Ft. from S. Line

Ft. from E. Line

330

Ft. from W. Line

NW NW NE

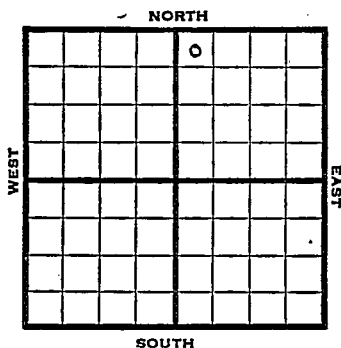

1951

Elev. 1829' REPORT

11/7

Spud 11-3-51

8" @ 162'

Drlg. 285'

11/28

Spud 11-3-51

D&A TD 3440

8" @ 162

Heeb. 3021

Br lime 3133

Lans. 3146

DST 3155-3220 opn 1 hr

Rec. 40' ocm

DST 3288-60 opn 45 min.

Rec. 50' mud


Cong. 3398 Arb. 3415-40

5" @ 3267 12/3211-14 500 A

1000 A FU 2112' wtr 120' oil

D&A

ABANDONED

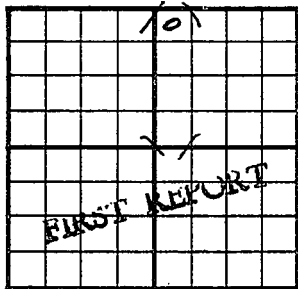
County Barton State KansasSec. 19 (Blk. Twp.) 19 (Sur. Rge.) 12W Map No.Operator Alpine OilWell No. 1 Farm McIlrath (B)Elev. Location NW NW NE330 Ft. From N Line NE330 Ft. From W Line Quarter1st. Report NOV 7 1951

Completion

Remarks

Spudding Date 11-3-51Drig. Data Ft Zarah8" @ 162 Drig. 285J. E. TYRA

County Barton State Kansas
 Sec. 19 (Blk. Twp.) 19 (Sur. Rge.) 12W Map No. _____
 Operator Alpine Oil & Royalty
 Well No. 1 Farm McIlrath "B"
 Elev. 1829 Location NW NW NE

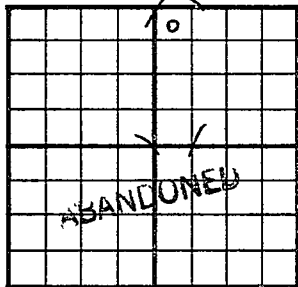

330 Ft. From N Line NE
330 Ft. From W Line Quarter
 Ist. Report _____
 Completion NOV 28 1951
 Remarks Ft. Zarah Pool

Spudding Date 11-3-51
 Drilg. Data D & A TD 3440

8" @ 162 Heeb. 3021 Br. lime 3133
Lans. 3146 DST 3155-3220 open 1 hr.
Rec. 40' ocm DST 3288-60 open 45 min.
Rec. 50' mud Cong. 3398 Arb. 3415-40
5" @ 3267 12/ 3211-14 500 A 1000 A
FU 2112' water 120' oil
D & A

J. E. TYRA