


Section 19 Township 19 Range 12 W

Well No. # 1 Schermuly

Company W. L. Hartman

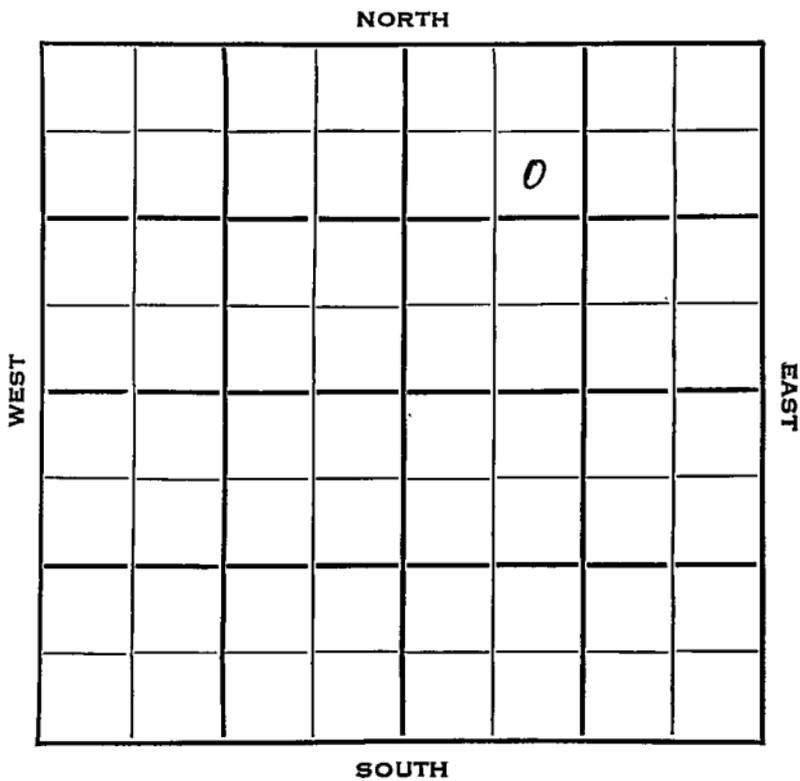

Barton

KANSAS

SEC.	TWP.	R.
19	19	12 W

WELL NO.

# 1 Schermuly

FARM

COMPANY

W. L. Hartman

CONTRACTOR

N. Ft. Zarah Pool


NORTH

990 Ft. from N. Line

Ft. from S. Line

Ft. from E. Line

990 Ft. from W. Line

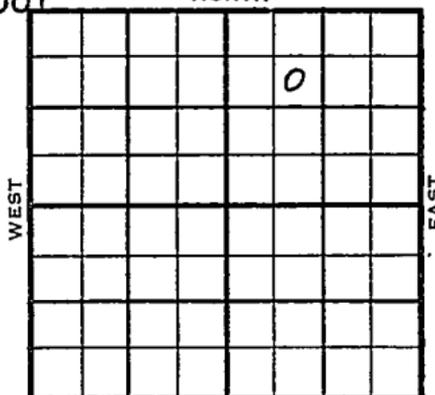

SE NW NE

ELEVATION

REPORT

1954 1827'

4/7 Spud 4-2-54  
 8" @ 160  
 Drlg. 1760'

5/12 Spud 4-2-54  
 Oil Well  
 TD 3439'  
 8" @ 160'  
 Top 2778', Heeb 3015', Br line  
 3127', Lans 3143', B KC 3383',  
 Cong 3388', Arb. 3436'  
 TD 3439'  
 5" @ 3438'  
 CO to 3439', 500A  
 Comp. 25 bopd

COMPLETED




County Barton State Kansas

Sec. 19 (Blk. 19) (Sur. 12W) Map No. 12W

Operator W. L. Hartman

Well No. 1 Farm Schermuly

Elev. 1827 Location SE NW NE

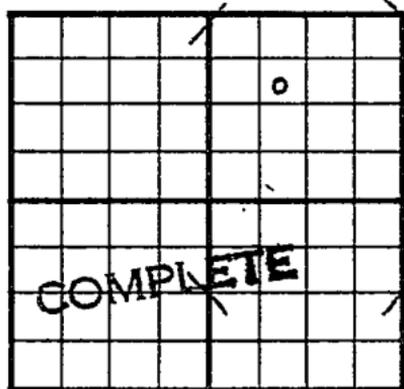

990 Ft. From N Line NE

990 Ft. From W Line Quarter

1st. Report

Completion MAY 12 1954

Remarks N. Ft. Zarah Pool

Spudding Date 4-2-54

Drlg. Data Oil well TD 3439

8" @ 160 Top. 2778 Heeb. 3015

Br. lime 3127 Lans. 3143 B KC 3383

Cong. 3388 Arb. 3436 TD 3439

5" @ 3438 CO to 3439 500 A

Comp. 25 bopd