


Section 19 Township 19 Range 10 WWell No. #1 DollCompany Bennett & Roberts

NORTH

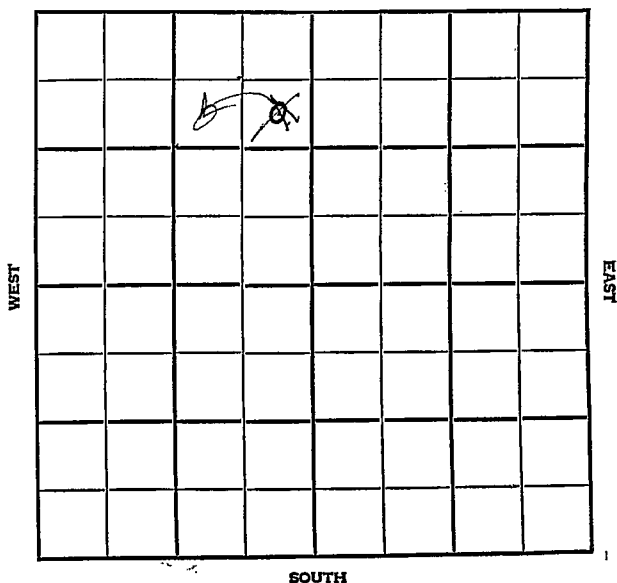

Rice

KANSAS

|      |      |     |
|------|------|-----|
| SEC. | TWP. | R.  |
| 19   | 19   | 10W |

WELL NO.

#1 Doll

FARM

COMPANY

Bennett &amp; Roberts

CONTRACTOR

Co. Tools


Ft. from N. Line

Ft. from S. Line

Ft. from E. Line

Ft. from W. Line

SW  
SE NE NW

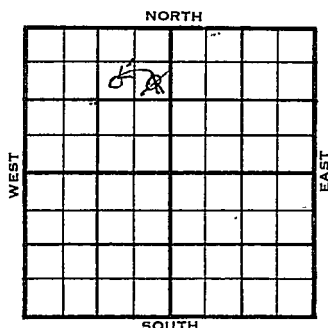

1956

ELEVATION

1773

REPORT

2-29- Location

4-11 Comm. 3-4-56  
 8 5/8" @ 191 w/160  
 DST 3015-46 op 1 hr. rec. 30' gcm,  
 700/20"  
 DST 3050-3100 op 1 hr. gas in 30 min.  
 rec. 390' gc&socm, 15' mw, 890/20"  
 5 1/2" @ 3302  
 DD 3309  
 FU 920' oil 11 hr., 1000 A  
 S/ 3 boph,  
 Comp. 25 bopd  
 Anh. 483  
 H. 2868  
 Tr. 2884  
 Dg. 2900  
 BL. 2986  
 L. 3003  
 A. 3301  
 #####  
 TD 3309'

COMPLETED



MAR 7 1956  
MAR 7 1956

R. G.

# CORRECTION

FORM 513 REV. SUNRAY

County Rice Elev. \_\_\_\_\_  
 Sec. 19 Twp. 19 Rge. LOW  
 Company Bennett & Roberts  
 Farm Name Doll No. 1

| TOPS   | DEPTH | LOG | DATUM | Loc. in Sec. _____ |
|--------|-------|-----|-------|--------------------|
| Anh.   |       |     |       | SW NE NW           |
| Tp.    |       |     |       |                    |
| H.     |       |     |       |                    |
| Tr.    |       |     |       |                    |
| Dg.    |       |     |       |                    |
| BL.    |       |     |       |                    |
| L.     |       |     |       | Geol. _____        |
| K.C.   |       |     |       | Contr. _____       |
| B.K.C. |       |     |       |                    |
| Ce.    |       |     |       |                    |
| C.     |       |     |       |                    |
| M.     |       |     |       |                    |
| M.     |       |     |       | Pool _____         |
| K.     |       |     |       |                    |
| Mz.    |       |     |       |                    |
| Ma.    |       |     |       |                    |
| V.     |       |     |       |                    |
| S.     |       |     |       |                    |
| S.     |       |     |       |                    |
| A.     |       |     |       |                    |
| R.     |       |     |       |                    |
| Pe.    |       |     |       |                    |
| G.     |       |     |       |                    |
| T.D.   |       |     |       |                    |

CORRECTION

Date Comm. APR 1 1 1956  
Reported SE NE NW

APR 19 1956

R. G.

County Rice Elev. 1773  
 Sec. 19 Twp. 19 Rge. 10W  
 Company Bennett & Roberts  
 Farm Name Doll No. 1

| TOPS   | DEPTH       | LOG | DATUM       |
|--------|-------------|-----|-------------|
| Anh.   | <u>483</u>  |     |             |
| TP.    |             |     |             |
| H.     | <u>2868</u> |     |             |
| Tr.    | <u>2884</u> |     |             |
| Dg.    | <u>2900</u> |     |             |
| BL.    | <u>2986</u> |     |             |
| L.     | <u>3003</u> |     | <u>1230</u> |
| K.C.   |             |     |             |
| B.K.C. |             |     |             |
| Ce.    |             |     |             |
| C.     |             |     |             |
| M.     |             |     |             |
| M.     |             |     |             |
| K.     |             |     |             |
| Mz.    |             |     |             |
| Mq.    |             |     |             |
| V.     |             |     |             |
| S.     |             |     |             |
| S.     |             |     |             |
| A      | <u>3301</u> |     | <u>1528</u> |
| R.     |             |     |             |
| PE.    |             |     |             |
| G.     |             |     |             |
| T.D.   | <u>3304</u> |     |             |


Loc. in Sec. SW NE NW

Geol. \_\_\_\_\_

Contr. \_\_\_\_\_

Co. tools \_\_\_\_\_

Pool \_\_\_\_\_

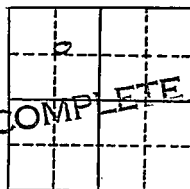

Date Comm. 3-4-56 APR 11 1956  
8 5/8" @ 191/160 DST 3015-46 open 1 hr.  
rec. 30' gcm 700/20" DST 3050-3100  
open 1 hr. gas in 30 min. rec. 390'  
gc & socm 15' mw 890/20" 5 1/2" @ 3302  
DD 3309 FU 920' oil 11 hr.  
1000 A S/ 3 boph Comp. 25 bopd

APR 19 1956

R. G.